


STATE OF KANSAS
STATE CORPORATION COMMISSION

WELL PLUGGING RECORD

Give All Information Completely
Make Required Affidavit
Mail or Deliver Report to
Conservation Division
State Corporation Comm.
245 North Water
Wichita, KS 67202

Ness County. Sec. 18 Twp. 19S Rge. 24W EXX
Location as "NE/CNW 1/4 SW 1/4" or footage from lines
C-SE SW

Lease Owner Pan-Western Petroleum, Inc.
Lease Name Dinges "A" Well No. 1
Office Address 1408 Douglas Bldg., Wichita, Ks. 67202
Character of Well (Completed as Oil, Gas or Dry Hole)

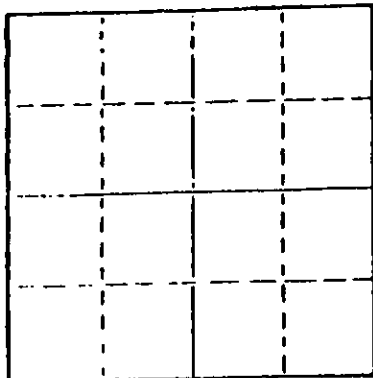

Dry Hole
Date Well completed June 23, 1978
Application for plugging filed Verbal Application 1978
Application for plugging approved Verbal Approval 1978
Plugging commenced June 23, 1978
Plugging completed June 23, 1978
Reason for abandonment of well or producing formation

If a producing well is abandoned, date of last production 19

Was permission obtained from the Conservation Division or its agents before plugging was commenced? Yes

Name of Conservation Agent who supervised plugging of this well Wm. T. Owen
Producing formation Depth to top Bottom Total Depth of Well 4,420

Show depth and thickness of all water, oil and gas formations.

OIL, GAS OR WATER RECORDS

CASING RECORD

FORMATION	CONTENT	FROM	TO	SIZE	PUT IN	PULLED OUT
				8-5/8"	413'	None

Describe in detail the manner in which the well was plugged, indicating where the mud fluid was placed and the method or methods used in introducing it into the hold. If cement or other plugs were used, state the character of same and depth placed, from feet to feet for each plug set.

Filled hole with heavy rotary mud from 4,420 ft. (rotary total depth) to 720 ft. Set plug at 720 ft. and cemented with 70 sacks cement. Filled hole with heavy rotary mud from 720 ft. to 400 ft. Set plug at 400 ft. and cemented with 40 sacks cement. Filled hole with heavy rotary mud from 400 ft. to 40 ft. Set solid plug at 40 ft. and cemented to cellar with 10 sacks cement, 3 sacks cement in rat hole.

Plugging operations accomplished utilizing Sun Oil Well cementing pump truck through 4 1/2 inch drill pipe.

(If additional description is necessary, use BACK of this sheet)

Name of Plugging Contractor Sun Oilwell Cementing, Inc.
Box 169, Great Bend, Kansas 67530


STATE OF Kansas COUNTY OF Sedgwick, ss.
Dean Britting, Agent

of the above-described well, being first duly sworn on oath, says: That I have knowledge of the facts, statements, and matters herein contained and the log of the above-described well as filed and that the same are true and correct. So help me God.

(Signature) Dean Britting
200 N. Main, Wichita, Kansas 67202
(Address)

SUBSCRIBED AND SWORN TO before me this 28th day of June, 1978

My commission expires June 30, 1978
Elsie Willison - Notary Public.

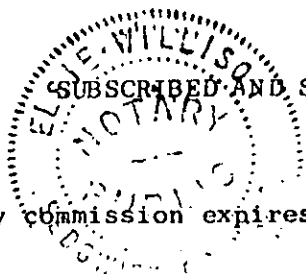

KANSAS DRILLERS LOG

COMPANY Pan-Western Petroleum, Inc.

SEC. 10 T. 12S R. 24E

FARM Dinges "A" NO. 1

LOC. C-33 SW

COUNTY Ness

ROTARY TOTAL DEPTH 4,420'

COMM. June 13, 1970

COMP. June 23, 1970

CONTRACTOR H-30, Inc.

ISSUED June 23, 1970

CASING

10 3/4"

8 5/8" Set at 413' cemented w/275 exo cement

ELEVATION 2,967 R.S.D.

5 1/2"

4 1/2"

FIGURES INDICATE BOTTOM OF FORMATIONS

Shale and Shells	625'
Shale	1,015'
Anhydrite	1,035'
Sand and Shale	1,290'
Shale	1,335'
Shale and Red Bed	1,565'
Anhydrite	1,605'
Shale and Lime	2,220'
Lime	2,465'
Shale and Lime	3,050'
Lime and Shale	3,531'
Shale and Lime	3,705'
Lime	4,420'
Rotary Total Depth	4,420'

RECEIVED
STATE CONSERVATION COMMISSION

JUN 30 1970

CONSERVATION DIVISION
Wichita, Kansas

I hereby certify the above and foregoing to be a true and correct log of the above described well as shown by the drilling reports.

H-30, Inc.

Dean Britting
Dean Britting

State of Kansas }
County of Sedgwick } ss:

Subscribed and Sworn to before me a Notary Public in and for said county and state this 25th day of June, 1970.

WILLISON
NOTARY
My Commission Expires:
June 30, 1970

Elsie Willison
Elsie Willison - Notary Public