


STATE OF KANSAS  
STATE CORPORATION COMMISSION

Give All Information Completely  
Make Required Affidavit  
Mail or Deliver Report to:  
Conservation Division  
State Corporation Commission  
211 No. Broadway  
Wichita, Kansas

WELL PLUGGING RECORD

NORTH

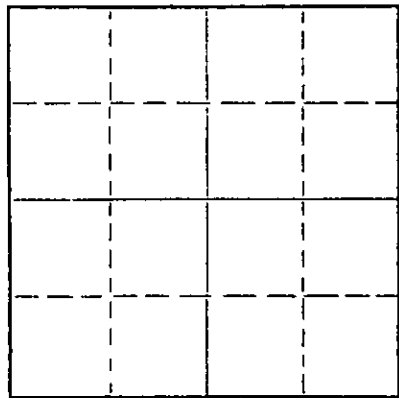

Locate well correctly on above  
Section Plat

Ness County. Sec. 9 Twp. 19 Rge. 26 (W)  
Location as "NE/CNW/SW" or footage from lines A/C NE/1 NE/1 NW/1  
Lease Owner Barnett Oil Company  
Lease Name Queen "B" Well No. 1  
Office Address 411 First National Bank Bldg., Wichita, Kansas  
Character of Well (completed as Oil, Gas or Dry Hole) Dry hole  
Date well completed August 16 1957  
Application for plugging filed August 16 1957  
Application for plugging approved August 16 1957  
Plugging commenced August 16 1957  
Plugging completed August 16 1957  
Reason for abandonment of well or producing formation \_\_\_\_\_

If a producing well is abandoned, date of last production \_\_\_\_\_ 19\_\_\_\_  
Was permission obtained from the Conservation Division or its agents before plugging was commenced? Yes

Name of Conservation Agent who supervised plugging of this well R. M. Brundage  
Producing formation \_\_\_\_\_ Depth to top \_\_\_\_\_ Bottom \_\_\_\_\_ Total Depth of Well 4512 Feet  
Show depth and thickness of all water, oil and gas formations.

OIL, GAS OR WATER RECORDS

CASING RECORD

FORMATION	CONTENT	FROM	TO	SIZE	PUT IN	PULLED OUT
				8 5/8	212 1/2	-0-

Describe in detail the manner in which the well was plugged, indicating where the mud fluid was placed and the method or methods used in introducing it into the hole. If cement or other plugs were used, state the character of same and depth placed, from \_\_\_\_\_ feet to \_\_\_\_\_ feet for each plug set.

Ran pipe to bottom of hole and circulated heavy mud on bottom. Built plug out of 8" X 8" X 6' plank. Pushed plug to 720'. Pumped in 100 sacks of cement. Filled hole to 200' with mud. Pushed plug and 1/3rd sack of hulls to 200'. Pumped in 5 sacks of cement. Filled pipe to 20' with mud. Pushed plug and 1/3rd sack of hulls to 20'. Filled hole with 5 sacks of cement to bottom of cellar.

Bridged rat hole with hulls and filled to surface with 5 sacks of cement.

(WELL LOG ATTACHED)

(If additional description is necessary, use BACK of this sheet)

Name of Plugging Contractor Barnett Drilling, Inc.,  
Address 409 First National Bank Bldg., Wichita, Kansas.

STATE OF Kansas, COUNTY OF Sedgwick, ss.  
F. H. Rousey, Office Mgr. for (employer of owner, lessee or operator) of the above-described well, being first duly sworn on oath, says: That I have knowledge of the facts, statements, and matters herein contained and the log of the above-described well as filed and that the same are true and correct. So help me God.

(Signature) F. H. Rousey  
411 First Natl. Bank Bldg., Wichita, Kansas  
(Address)

SUBSCRIBED AND SWORN TO before me this 21 day of August, 1957

My commission expires January 14, 1958

Harold O. Erhard  
Notary Public.

PLUGGING  
FILE SEC 9 T 19 R 26  
BOOK PAGE 37 LINE 15

8-22-57

15-135-00125-0000

BARNETT OIL COMPANY  
WELL LOG  
QUEEN "B" WELL NO. 1  
A/C NE/4 NE/4 NW/4 of Section 9-19S-26W,  
NESS COUNTY, KANSAS

Date started: August 2, 1957  
Date completed: August 16, 1957

<u>From</u>	<u>To</u>	
0	50	Rock and post rock
50	65	Sand
65	475	Shale
475	675	Sand
675	1,310	Shale and shells
1,310	1,530	Sandy shale
1,530	1,830	Shale
1,830	1,865	Anhydrite
1,865	2,240	Shale and shells
2,240	2,620	Shale
2,620	2,735	Shale and lime
2,735	3,035	Lime
3,035	3,115	Lime and shale
3,115	3,345	Lime
3,345	3,440	Lime and shale
3,440	3,685	Lime
3,685	3,790	Lime and shale
3,790	4,512	Lime (Total Depth - D. & A.)

Set 212 $\frac{1}{2}$  ' of 8 5/8th - 24# s. s. casing with 150 sacks of cement.

PLUGGING	
FILE SEC	9 T 19 R 26W
BOOK PAGE	37 LINE 15

RECEIVED  
AUG 21 1957  
GEOLOGICAL DIVISION  
WICHITA, KANSAS