


WELL PLUGGING RECORD

Give All Information Completely
Make Required Affidavit
Mail or Deliver Report to:
Conservation Division
State Corporation Commission
800 Bittling Building
Wichita, Kansas

NORTH

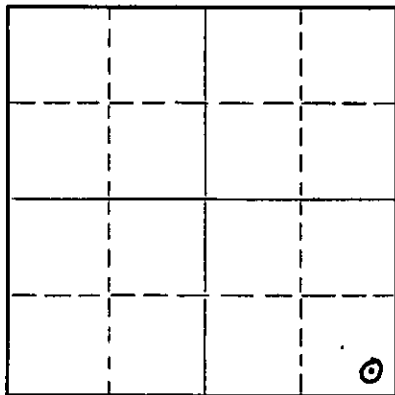

Locate well correctly on above
Section Flat

Ness County, Sec. 3 Twp. 19 Rge. 26 (E) (W)
Location as "NE/CNW $\frac{1}{4}$ /SW $\frac{1}{4}$ " or footage from lines SE $\frac{1}{4}$ SE $\frac{1}{4}$ SE $\frac{1}{4}$
Lease Owner Wedall-Levan
Lease Name Pambar Well No. 1
Office Address Great Bend
Character of Well (completed as Oil, Gas or Dry Hole) Dry
Date well completed 7-23-51 19
Application for plugging filed 7-23-51 19
Application for plugging approved 7-23-51 19
Plugging commenced 7-23-51 19
Plugging completed 7-23-51 19
Reason for abandonment of well or producing formation Dry

If a producing well is abandoned, date of last production none 19
Was permission obtained from the Conservation Division or its agents before plugging was commenced? Yes

Name of Conservation Agent who supervised plugging of this well Mr. Stough
Producing formation none Depth to top Bottom Total Depth of Well 4651 Feet
Show depth and thickness of all water, oil and gas formations.

OIL, GAS OR WATER RECORDS

CASING RECORD

Formation	Content	From	To	Size	Put In	Pulled Out

Describe in detail the manner in which the well was plugged, indicating where the mud fluid was placed and the method or methods used in introducing it into the hole. If cement or other plugs were used, state the character of same and depth placed, from _____ feet to _____ feet for each plug set.

Filled hole with heavy mud to 236 ft. Bridged hole at 236' and cemented with 15 sacks filled hole to 33 ft. with heavy mud. Cemented with 10 sacks to top of surface pipe.

8-3-51

(If additional description is necessary, use BACK of this sheet)

Correspondence regarding this well should be addressed to _____
Address _____

STATE OF KANSAS, COUNTY OF NESS, ss.
UYRL W. LEVAN (employee of owner) or (owner or operator) of the above-described well,
being first duly sworn on oath, says: That I have knowledge of the facts, statements, and matters herein contained and the log of the above-described well as filed and that the same are true and correct. So help me God.

(Signature) Uyrl Levan
NESS CITY - KS.
(Address)

SUBSCRIBED AND SWORN to before me this 1 day of AUGUST, 1951.

Frances Stone
Notary Public.

My commission expires JUNE 10-1954

PLUGGING
FILE SEC 3 T 19 R 26
BOOK PAGE 27 LINE 31

Verl Levan and E. C. Wedell
Ness City and Great Bend, Kansas

Plumber no. 1

Sec. 3-19-26W

Ness County, Kansas

Commenced R. D.: 7/3/51
Completed R. D.: 7/23/51
Total Depth: 4651'
Casing Record: 230' of 8 5/8" 8rd. thd.

Initial Prod: DRY
Elevation: 2571
Contractor: S. A. Berwick
Drilling Co.

Strata	Depth
Surface Soil and Limestone	0 - 60'
Water Sand	60 - 90
Limestone and Shale	90 - 230
Shale and Sand	230 - 1040
Redbed and Shells	1040 - 1255
Anhydrite	1255 - 1280
Shale and Shells	1280 - 1960
Lime and Shale	1960 - 3130
Shale	3130 - 3270
Shale and Shells	3270 - 3535
Shale and Lime	3535 - 3738
Shale	3738 - 3760
Shale and Lime	3760 - 3950
Lime	3950 - 4545
Chert and Lime	4545 - 4590
Lime	4590 - 4651

I hereby certify the above a true and correct log of said well as reflected by the Daily Drilling Reports of the S. A. Berwick Drilling Co.

S. A. BERWICK DRILLING CO.

by S. A. Berwick

Signed and sworn to in my presence this 25th day of July, 1951.

[Signature]
Notary Public

My Commission Expires: Feb 16, 1955

PLUGGING
FILE SEC-5-719-R-26W
BOOK PAGE-97 LINE-31