

15-109-20,459-0000

STATE CORPORATION COMMISSION OF KANSAS  
OIL & GAS CONSERVATION DIVISION  
WELL COMPLETION OR RECOMPLETION FORM  
ACO-1 WELL HISTORY  
DESCRIPTION OF WELL AND LEASE

Operator: License # 8541  
Name PETEX, Inc.  
Address 1111 S. Glenstone, #1-104  
City/State/Zip Springfield, MO 65804

Purchaser Clear Creek, Inc.  
McPherson, KS

Operator Contact Person Larry Childress  
Phone (417) 862-2177

Contractor: License # 5104  
Name Blue Goose Drilling

Wellsite Geologist Thomas Funk  
Phone (316) 686-5836

Designate Type of Completion  
 New Well  Re-Entry  Workover

Oil  SWD  Temp Abd  CONSERVATION DIVISION  
 Gas  Inj  Delayed Comp. Wichita, Kansas  
 Dry  Other (Core, Water Supply etc.)

If OWNED: old well info as follows:  
Operator  
Well Name  
Comp. Date Old Total Depth

WELL HISTORY


Drilling Method:  
 Mud Rotary  Air Rotary  Cable  
5/6/88 5/13/88 5/25/88  
Spud Date Date Reached TD Completion Date  
4745  
Total Depth PBTD

Amount of Surface Pipe Set and Cemented at 210 feet  
Multiple Stage Cementing Collar Used?  Yes  No  
If yes, show depth set 2614 feet  
If alternate 2 completion, cement circulated from 2614 feet depth to surface 532x cmt  
Cement Company Name Allied Cementing  
Invoice # 51652  
7-5-88

API NO. 15-109-20,459-0000  
County Logan  
NW, NW, NW Sec 33 Twp 12S Rge 33 East West  
4950 Ft North from Southeast Corner of Section  
4950 Ft West from Southeast Corner of Section  
(Note: Locate well in section plat below)

Lease Name Ahrens Well # 1  
Field Name Owens Southwest  
Producing Formation Johnson  
Elevation: Ground 3124 KB 3131

Section Plat

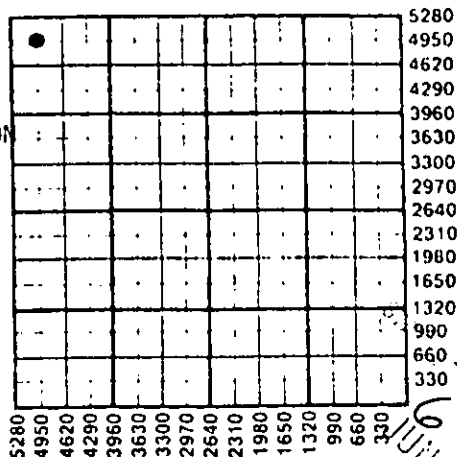

WATER SUPPLY INFORMATION

Disposition of Produced Water:  Disposal  Repressuring  
Docket #

Questions on this portion of the ACO-1 call:

Water Resources Board (913) 296-3717

Source of Water:  
Division of Water Resources Permit #  
Groundwater Ft North from Southeast Corner (Well) Ft West from Southeast Corner of Sec Twp Rge East West  
 Surface Water Ft North from Southeast Corner (Stream, pond etc) Ft West from Southeast Corner Sec Twp Rge East West  
Other (explain) (purchased from city, R.W.D. #)

INSTRUCTIONS: This form shall be completed in triplicate and filed with the Kansas Corporation Commission, 200 Colorado Derby Building, Wichita, Kansas 67202, within 120 days of the spud date of any well. Rule 82-3-130, 82-3-107 and 82-3-106 apply. Information on side two of this form will be held confidential for a period of 12 months if requested in writing and submitted with the form. See rule 82-3-107 for confidentiality in excess of 12 months. One copy of all wireline logs and drillers time log shall be attached with this form. Submit CP-4 form with all plugged wells. Submit CP-111 form with all temporarily abandoned wells.

All requirements of the statutes, rules and regulations promulgated to regulate the oil and gas industry have been fully complied with and the statements herein are complete and correct to the best of my knowledge.

Signature Larry Childress  
Title President Date 6/17/88

Subscribed and sworn to before me this 17th day of June 1988  
Notary Public Peggy Sleethman  
Date Commission Expires 7/29/91

K.C.C. OFFICE USE ONLY  
 Letter of Confidentiality Attached  
 Wireline Log Received  
 Drillers Timelog Received  
Distribution  
 KCC  SWD/Rep  NGPA  
 KGS  Plug  Other (Specify)  
6-20-88 X

RECEIVED STATE CORPORATION COMMISSION

JUN 20 1988

CONSERVATION DIVISION Wichita, Kansas

RECEIVED STATE CORPORATION COMMISSION JUN 30 1988

Sec 33 Twp 12S Rge 33E