

CARD MUST BE TYPED

State of Kansas
NOTICE OF INTENTION TO DRILL
 (see rules on reverse side)

CORRECTION

2nd COLLECTION
 CARD MUST BE SIGNED
 6-6-85

Starting Date: 6/10/85
 month day year

OPERATOR: License # 9896
 Name Bonray Energy Corporation
 Address P. O. Box 20746
 City/State/Zip Oklahoma City, OK 73156
 Contact Person Lee R. Troiani
 Phone (405) 848-6891

CONTRACTOR: License #
 Name
 City/State

Well Drilled For: Oil Well Class: Wildcat Type Equipment:

☒ Oil ☐ Swd ☐ Infield ☒ Mud Rotary
☐ Gas ☐ Inj ☐ Pool Ext. ☐ Air Rotary
☐ OWWO ☐ Expl ☒ Wildcat ☐ Cable

If OWWO: old well info as follows:

Operator

Well Name

Comp Date Old Total Depth

Projected Total Depth 4650' feet

Projected Formation at TD Miss Dol

Expected Producing Formations Miss, Ft. Scott, Marmaton

I certify that we will comply with K.S.A. 55-101, et seq., plus eventually plugging hole to K.C.C. specifications.

Date 6/10/85 Signature of Operator or Agent

API Number 15- 135-22,813-0000

SE SE NE Sec . 9 . Twp 19 . S, Rge . 26W ☐ East
 (location) ☒ West

2970 Ft North from Southeast Corner of Section

570 Ft West from Southeast Corner of Section
 (Note: Locate well on Section Plat on reverse side)

Nearest lease or unit boundary line 330 feet.

County Ness

Lease Name ~~WINDY~~ BRENNER Well# 9-1

Domestic well within 330 feet : ☐ yes ☒ no

Municipal well within one mile : ☐ yes ☒ no

Depth to Bottom of fresh water 100 feet

Lowest usable water formation Dakota

Depth to Bottom of usable water 800 feet

Surface pipe by Alternate : 1 ☒ 2 ☐

Surface pipe to be set 800 feet

Conductor pipe if any required feet

Ground surface elevation 2600 feet MSL

This Authorization Expires 11-3-85

Approved By 5-3-85

Date 6/10/85 Signature of Operator or Agent

Title


Land Manager

Must be filed with the K.C.C. five (5) days prior to commencing well
 RECEIVED This card void if drilling not started within six (6) months of date received by K.C.C.

STATE CORPORATION COMMISSION

JUN 10 1985

A Regular Section of LAND
 1 Mile $\times$ 5,280 Ft. Kansas

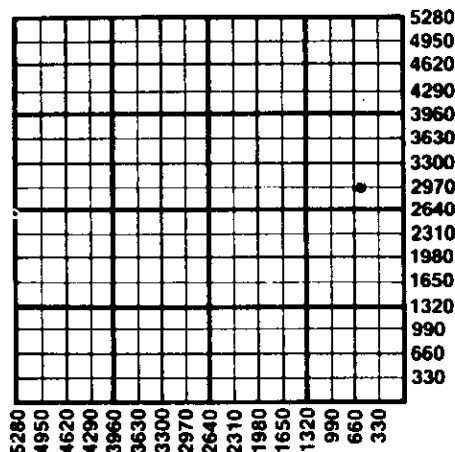

Important procedures to follow :

1. Notify District office before setting surface casing.
2. Set surface casing by circulating cement to the top.
3. File completion forms ACO-1 with K.C.C. within 90 days of well completion, following instructions on ACO-1, side 1, and including copies of wireline logs.
4. Notify District office 48 hours prior to old well workover or re-entry.
5. Prior to plugging, prepare a plugging plan, then obtain agreement from the appropriate district office for an approved plugging plan.
6. Submit plugging report (CP-4) to K.C.C. after plugging is completed.
7. Obtain an approved injection docket number before disposing of salt water.
8. Notify K.C.C. within 10 days when injection commences or terminates.
9. If an alternate 2 completion, cement in the production pipe from below any usable water to surface within 120 days of spud date.

State Corporation Commission of Kansas
 Conservation Division
 200 Colorado Derby Building
 Wichita, Kansas 67202
 (316) 263-3238