

CARD MUST BE TYPED

State of Kansas
NOTICE OF INTENTION TO DRILL

CARD MUST BE SIGNED

(see rules on reverse side)

Starting Date: 12 3 84
month day year

API Number 15- 135-22,722-0000

OPERATOR: License # 6009

C SE NW Sec 29 Twp 19 S, Rge 24 East
(location) West

Name Double Eagle Exploration, Inc.

Address 100 S. Main, Suite 410

City/State/Zip Wichita, KS 67202

Contact Person Jim Robinson,

Phone 267-3316

..... 3300 Ft North from Southeast Corner of Section

..... 3300 Ft West from Southeast Corner of Section

(Note: Locate well on Section Plat on reverse side)

CONTRACTOR: License # 5146

Name Rains & Williamson

City/State Wichita, KS 67202

Nearest lease or unit boundary line 660 feet.

County Ness

Lease Name Mellies Well# #1

Domestic well within 330 feet: yes no

Municipal well within one mile: yes no

Well Drilled For: Well Class: Type Equipment:

Oil Swd Infield Mud Rotary

Gas Inj Pool Ext. Air Rotary

OWWO Expl Wildcat Cable

If OWWO: old well info as follows:

Operator

Well Name

Comp Date Old Total Depth

Projected Total Depth 4400' feet

Projected Formation at TD .. Mississippi

Expected Producing Formations .. Mississippi

Depth to Bottom of fresh water 200 feet

Lowest usable water formation Dakota

Depth to Bottom of usable water 600 feet

Surface pipe by Alternate: 1 2

Surface pipe to be set 350 feet

Conductor pipe if any required NA

Ground surface elevation NA feet MSI.

This Authorization Expires 5-9-85

Approved By 11-9-84 *hc*

I certify that we will comply with K.S.A. 55-101, et seq., plus eventually plugging hole to K.C.C. specifications.

Date 11/8/84 Signature of Operator or Agent *Jim Robinson*

Title President


Form C-1 4/84

MHC/WOKE 11/8/84

Must be filed with the K.C.C. five (5) days prior to commencing well
 This card void if drilling not started within six (6) months of date received by K.C.C.

Important procedures to follow :

**A Regular Section of Land
 1 Mile = 5,280 Ft.**

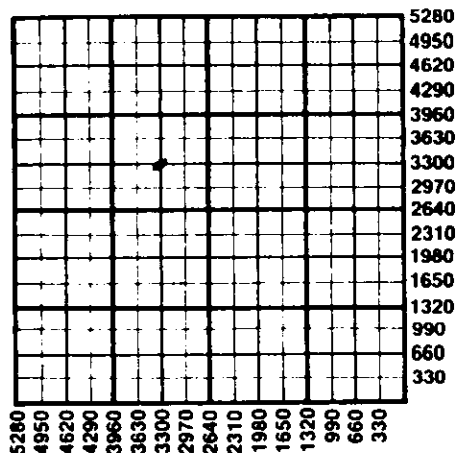

1. Notify District office before setting surface casing.
2. Set surface casing by circulating cement to the top.
3. File completion forms ACO-1 with K.C.C. within 90 days of well completion, following instructions on ACO-1, side 1, and including copies of wireline logs.
4. Notify District office 48 hours prior to shut well workover or re-entry.
5. Prior to plugging, prepare a plugging plan, then obtain agreement from the appropriate district office for an approved plugging plan.
6. Submit plugging report (P-4) to K.C.C. after plugging is completed.
7. Obtain an approved injection docket number before disposing of salt water.
8. Notify K.C.C. within 10 days when injection commences or terminates.
9. If an alternate 2 completion, cement in the production pipe from below any usable water to surface within 120 days of spud date.

State Corporation Commission of Kansas
 Conservation Division
 200 Colorado Derby Building
 Wichita, Kansas 67202
 (316) 263-3238