

FOR KCC USE:

EFFECTIVE DATE: 9-2-92

DISTRICT # 4

SSA? Yes No

State of Kansas

NOTICE OF INTENTION TO DRILL

Must be approved by the K.C.C. five (5) days prior to commencing well

FORM C-1 7/91 FORM MUST BE TYPED FORM MUST BE SIGNED ALL BLANKS MUST BE FILLED

Expected Spud Date 10 1992 month day year

Spot NE SE SW Sec 6 Twp 11 S. Rg 18 East West

OPERATOR: License # 6273 ROBERT R. PRICE OPERATING, INC. Name: P.O. BOX 470442 Address: Tulsa, OK 74147 City/State/Zip: Robert R. Price Contact Person: AC 918 492-1694 Phone:

990 feet from South / NECK line of Section 2310 feet from West / West line of Section IS SECTION XY REGULAR IRREGULAR

(NOTE: Locate well on the Section Plat on Reverse Side) County: Ellis Lease Name: Peavey Well #: 4 Field Name: Cochran Anderson South

CONTRACTOR: License #: advise prior to spud date Name: Unknown

Is this a Prorated/Spaced Field? yes no Target Formation(s): Lansing-Kansas City Nearest lease or unit boundary: 990'

Well Drilled For: Well Class: Type Equipment: X Oil Enh Rec X Infield X Mud Rotary Gas Storage Pool Ext. Air Rotary OUVO Disposal Wildcat Cable Seismic: # of Holes Other

Ground Surface Elevation: 1960 feet MSL Water well within one-quarter mile: yes no Public water supply well within one mile: yes no

If OUVO: old well information as follows: Operator: Well Name: Comp. Date: Old Total Depth

Depth to bottom of fresh water: 125-450 Depth to bottom of usable water: 600-610 Surface Pipe by Alternate: 1 X 2

Directional, Deviated or Horizontal wellbore? yes no If yes, true vertical depth: Bottom Hole Location

Length of Surface Pipe Planned to be set: 200' Length of Conductor pipe required: None Projected Total Depth: 3550'

AFFIDAVIT Once duplicate of 051-24803-2

The undersigned hereby affirms that the drilling, completion and eventual plugging of this well will comply with K.S.A. 55-101, et. seq.

It is agreed that the following minimum requirements will be met:

- 1. Notify the appropriate district office prior to spudding of well; 2. A copy of the approved notice of intent to drill shall be posted on each drilling rig; 3. The minimum amount of surface pipe as specified below shall be set by circulating cement to the top; in all cases surface pipe shall be set through all unconsolidated materials plus a minimum of 20 feet into the underlying formation; 4. If the well is dry hole, an agreement between the operator and the district office on plug length and placement is necessary prior to plugging; 5. The appropriate district office will be notified before well is either plugged or production casing is cemented in; 6. IF AN ALTERNATE II COMPLETION, PRODUCTION PIPE SHALL BE CEMENTED FROM BELOW ANY USABLE WATER TO SURFACE WITHIN 120 DAYS OF SPUD DATE. IN ALL CASES, NOTIFY DISTRICT OFFICE PRIOR TO ANY CEMENTING.

I hereby certify that the statements made herein are true and to the best of my knowledge and belief.

Date: 8-6-92 Signature of Operator or Agent: Title: President

FOR KCC USE: API # 15- 051-24803-0000 Conductor pipe required None feet Minimum surface pipe required 200 feet per Alt. X(2) Approved by: C.B. 8-28-92 This authorization expires: 2-28-93 (This authorization void if drilling not started within 6 months of effective date.) Spud date: Agent:

RECEIVED STATE DEPARTMENT OF CONSERVATION

AUG 27 1992

CONSERVATION DIVISION Wichita, Kansas

REMEMBER TO:

- File Drill Pit Application (form CDP-1) with Intent to Drill; - File Completion Form ACO-1 within 120 days of spud date; - File acreage attribution plat according to field prorations orders; - Notify appropriate district office 48 hours prior to workover or re-entry; - Submit plugging report (CP-4) after plugging is completed; - Obtain written approval before disposing or injecting salt water.

Mail to: Conservation Division, 200 Colorado Derby Building, 202 W. First St., Wichita, Kansas 67202-1286.

IN ALL CASES PLOT THE INTENDED WELL ON THE PLAT BELOW

PLAT OF ACREAGE ATTRIBUTABLE TO A WELL IN A PRORATED OR SPACED FIELD

If the intended well is in a prorated or spaced field, please fully complete this side of the form. If the intended well is in a prorated or spaced field complete the plat below showing that the well will be properly located in relationship to other wells producing from the common source of supply. Please show all the wells within 1 mile of the boundaries of the proposed acreage attribution unit for gas wells and within 1/2 mile of the boundaries of the proposed acreage attribution unit for oil wells.

API NO. 15- _____
 OPERATOR _____
 LEASE _____
 WELL NUMBER _____
 FIELD _____

LOCATION OF WELL: COUNTY _____
 _____ feet from south/north line of section
 _____ feet from east/west line of section
 SECTION _____ TWP _____ RG _____

NUMBER OF ACRES ATTRIBUTABLE TO WELL _____
 QTR/QTR/QTR OF ACREAGE _____



IS SECTION _____ REGULAR or _____ IRREGULAR
IF SECTION IS IRREGULAR, LOCATE WELL FROM NEAREST CORNER BOUNDARY.

Section corner used: _____ NE _____ NW _____ SE _____ SW

PLAT

(Show location of the well and shade attributable acreage for prorated or spaced wells.)
 (Show footage to the nearest lease or unit boundary line.)

R 18 W

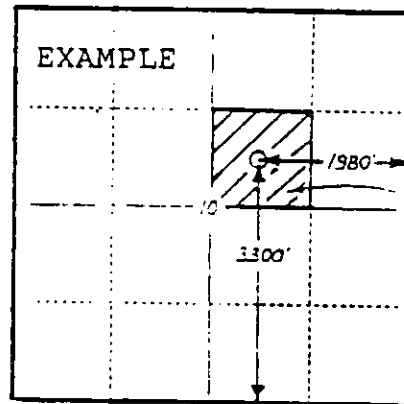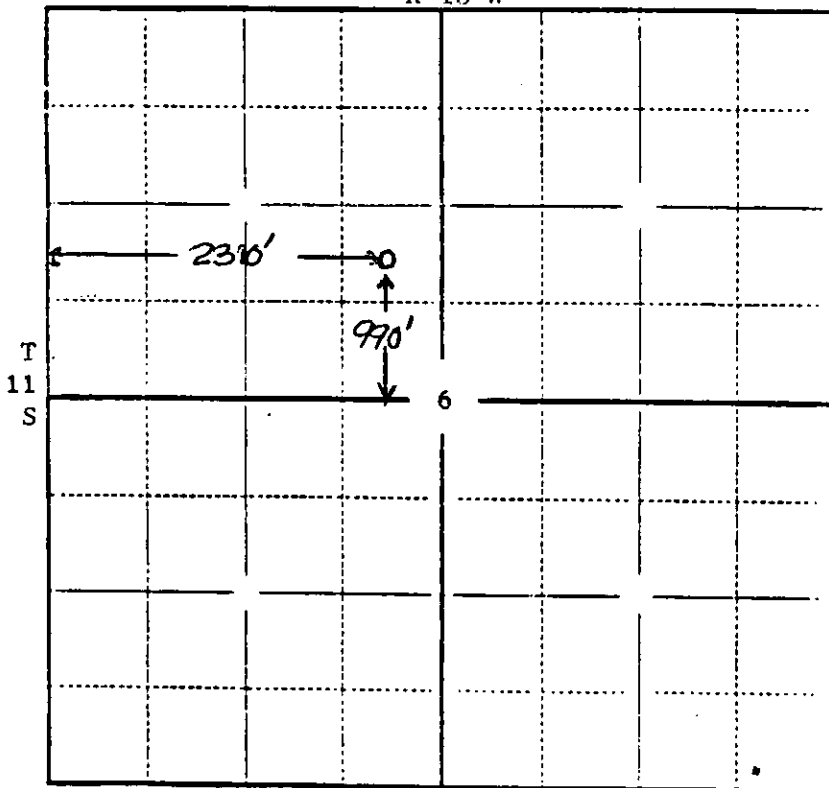

40
ACRES

SEWARD CO.

In plotting the proposed location of the well, you must show:

- 1) The manner in which you are using the depicted plat by identifying section lines, i.e. 1 section, 1 section with 8 surrounding sections, 4 sections, etc.;
- 2) the distance of the proposed drilling location from the section's south/north and east/west lines; and
- 3) the distance to the nearest lease or unit boundary line.