

Production string will be cemented immediately upon commencement of completion. *Flow*

CARD MUST BE TYPED

NOTICE OF INTENTION TO DRILL

(see rules on reverse side)

CARD MUST BE SIGNED

below usable water to surface

Starting Date: 8 21 85
month day year

API Number 15- *071-20,381-00-00* *Ke*

OPERATOR: License # *5171*
Name *TXO Production Corp.*
Address *1800 Lincoln Center Building*
City/State/Zip *Denver, Colorado...80264*
Contact Person *Frank D. Tsuru*
Phone *(303) 861-4246*

SW SE NE Sec *6* Twp *16* S, Rge *42* East West
(location)

2970 Ft North from Southeast Corner of Section
990 Ft West from Southeast Corner of Section
(Note: Locate well on Section Plat on reverse side)

CONTRACTOR: License # *Unknown*
Name
City/State

Nearest lease or unit boundary line *990* feet.
County *SREELBY*

Lease Name *BERGQUIST* Well# *3*

Well Drilled For: Well Class: Type Equipment:
 Oil Swd Infield Mud Rotary
 Gas Inj Pool Ext. Air Rotary
 OWWO Expl Wildcat Cable

Domestic well within 330 feet: yes no
Municipal well within one mile: yes no

If OWWO: old well info as follows:
Operator
Well Name
Comp Date Old Total Depth
Projected Total Depth *5300'* feet
Projected Formation at TD *Mississippian*
Expected Producing Formations *Morrow*

Depth to Bottom of fresh water *400* feet
Lowest usable water formation *Cheyenne DAK*
Depth to Bottom of usable water *1700* feet
Surface pipe by Alternate: 1 2
Surface pipe to be set *450-475* feet
Conductor pipe if any required *None* feet
Ground surface elevation *TBD* feet MSI
This Authorization Expires *2-6-86*
Approved By *8-6-85* *Ke*

I certify that we will comply with K.S.A. 55-101, et seq., plus eventually plugging hole to K.C.C. specifications.

Date *July 26, 1985* Signature of Operator or Agent *Frank D. Tsuru* Title *DRLG/PROD. ENGINEER*
REC for KONG


Must be filed with the K.C.C. five (5) days prior to commencing well
This card will be void if drilling not started within six (6) months of date received by K.C.C.

RECEIVED
STATE CORPORATION COMMISSION

AUG 6 1985

A Regular Section of Land
1 Mile = 5,280 Ft.

CONSERVATION DIVISION
Wichita, Kansas

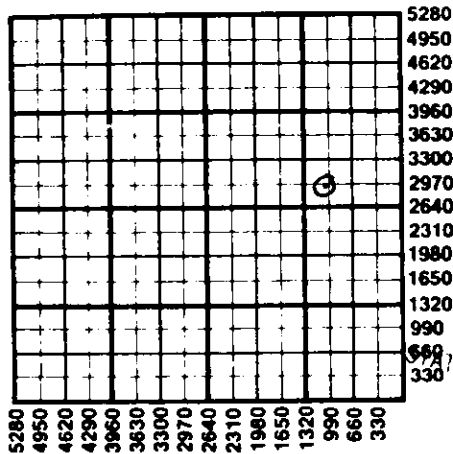

Important procedures to follow :

1. Notify District office before setting surface casing.
 2. Set surface casing by circulating cement to the top.
 3. File completion forms ACO-1 with K.C.C. within 90 days of well completion, following instructions on ACO-1, side 1, and including copies of wireline logs.
 4. Notify District office 48 hours prior to old well workover or re-entry.
 5. Prior to plugging, prepare a plugging plan, then obtain agreement from the appropriate district office for an approved plugging plan.
 6. Submit plugging report (CP-4) to K.C.C. after plugging is completed.
 7. Obtain an approved injection docket number before disposing of salt water.
 8. Notify K.C.C. within 10 days when injection commences or terminates.
- If an alternate 2 completion, cement in the production pipe from below any usable water to surface within 120 days of spud date.

RECEIVED
STATE CORPORATION COMMISSION
JUL 31 1985
7-31-85
CONSERVATION DIVISION
Wichita, Kansas

State Corporation Commission of Kansas
Conservation Division
200 Colorado Derby Building
Wichita, Kansas 67202
(316) 263-3238