

NOTICE OF INTENTION TO DRILL AMENDED*

(see rules on reverse side)

11-27-85

Starting Date 12 02 85*
month day year

API Number 15— 071-20,402-0000

OPERATOR: License # 5171
Name TXO Production Corp.
Address 1800 Lincoln Center Bldg.
City/State/Zip Denver, CO 80264
Contact Person Frank Tsuru
Phone 303-861-4246

*SE NE NW Sec. 6 Twp. 16 S. Rg. 42 East West
*4290 Ft. from South Line of Section
*2970 Ft. from East Line of Section

(Note: Locate well on Section Plat on reverse side)

CONTRACTOR: License # 6033
Name Murfin Drilling Company
City/State Wichita, KS

Nearest lease or unit boundary line 330 feet
County Greeley
Lease Name Edsall "G" Well # 9

Well Drilled For: Well Class: Type Equipment:
 Oil SWD Infield Mud Rotary
 Gas Inj Pool Ext. Air Rotary
 OWWO Expl Wildcat Cable

Ground surface elevation TBD feet MSL
Domestic well within 330 feet: yes no
Municipal well within one mile: yes no
Surface pipe by Alternate: 1 2 X

If OWWO: old well info as follows:

Depth to bottom of fresh water 330
Depth to bottom of usable water 1700
Surface pipe planned to be set 350
Projected Total Depth 5300 feet
Formation Morrow

Operator
Well Name
Comp Date Old Total Depth

I certify that well will comply with K.S.A. 55-101, et seq., plus eventually plugging hole to KCC specifications.

 cementing will be done immediately upon setting production casing.

Date 11-27-85 Signature of Operator or Agent J. E. Goss Title Ass't. Drilg. Mgr.

For KCC Use:
Conductor Pipe Required feet; Minimum Surface Pipe Required feet per Alt. 1 2


This Authorization Expires 4-11-86 Approved By J. E. Goss 12-11-85

Must be filed with the K.C.C. five (5) days prior to commencing well
This card void if drilling not started within six (6) months of date received by K.C.C.

Important procedures to follow:

1. Notify District office before setting surface casing.
 2. Set surface casing by circulating cement to the top.
 3. File completion forms ACO-1 with K.C.C. within 90 days of well completion, following instructions on ACO-1, side 1, and including copies of wireline logs.
 4. Notify District office 48 hours prior to old well workover or re-entry.
 5. Prior to filing Intent, prepare a proposed plugging plan in case well is D & A, then obtain approval of plan when calling district office prior to setting surface pipe.
 6. Submit plugging report (CP-4) to K.C.C. after plugging is completed.
 7. Obtain an approved injection docket number before disposing of salt water.
- Notify K.C.C. within 10 days when injection commences or terminates

A Regular Section of Land 1 Mile = 5,280 Ft.

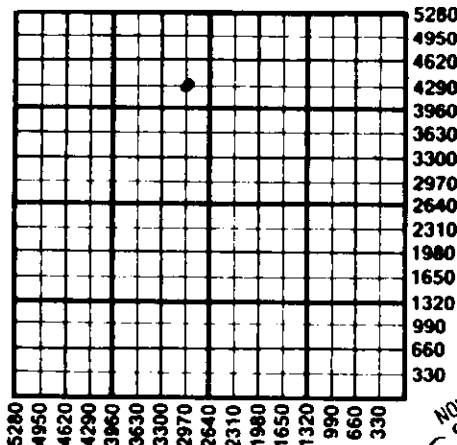

an alternate 2 completion, cement in the production pipe from below any usable water to surface within 120 days of spud date.

State Corporation Commission of Kansas
Conservation Division
200 Colorado Derby Building
Wichita, Kansas 67202
(316) 263-3238

RECEIVED
STATE CORPORATION COMMISSION
NOV 27 1995
CONSERVATION DIVISION