

CARD MUST BE TYPED **CORRECTED**

State of Kansas  
**NOTICE OF INTENTION TO DRILL**  
(see rules on reverse side)

**CORRECTED** CARD MUST BE SIGNED  
8-2-85

Starting Date: August 10, 1985  
month day year

API Number 15- 071-20,376-0000

OPERATOR: License # KCC #4034  
Name Remuda Corporation  
Address 490 N. 31st Street, Suite 308  
City/State/Zip Billings, MT 59101  
Contact Person Norm Brown  
Phone 316-275-0302

NE  NW  SW  SE Sec 6 Twp 16 S, Rge 42  East  West  
(location)

\* 2210..... Ft North from Southeast Corner of Section  
\* 4610..... Ft West from Southeast Corner of Section  
(Note: Locate well on Section Plat on reverse side)

CONTRACTOR: License # KCC #6033  
Name Murfin Drilling Co.  
City/State Wichita, KS 67202

Nearest lease or unit boundary line 330..... feet.  
County Greeley  
Lease Name Cheek Well# 5  
Domestic well within 330 feet:  yes  no  
Municipal well within one mile:  yes  no

Well Drilled For: Well Class: Type Equipment:  
 Oil  Swd  Infield  Mud Rotary  
 Gas  Inj  Pool Ext.  Air Rotary  
 OWWO  Expl  Wildcat  Cable

Depth to Bottom of fresh water 240..... feet  
Lowest usable water formation Dakota.....  
Depth to Bottom of usable water 1750..... feet  
Surface pipe by Alternate: 1  2   
Surface pipe to be set 450..... feet  
Conductor pipe if any required..... feet  
Ground surface elevation 3910..... feet MSI.  
This Authorization Expires 1-29-86  
Approved By 7-29-85

If OWWO: old well info as follows:

Operator.....  
Well Name.....  
Comp Date..... Old Total Depth.....  
Projected Total Depth 5,300..... feet  
Projected Formation at TD Mississippian.....  
Expected Producing Formations Morrow.....

I certify that we will comply with K.S.A. 55-101, et seq., plus eventually plugging hole to K.C.C. specifications. Production casing will be cemented immediately upon completion of well from below the usable water to the surface.

Date 7/30/85 Signature of Operator or Agent


Edward P. [Signature] Title Vice Pres. the surface.

\* was used 2220 2220 2220  
4710 FEB Form C-1 4/84

Must be filed with the K.C.C. five (5) days prior to commencing well  
This card void if drilling not started within six (6) months of date received by K.C.C.

**Important procedures to follow :**

**A Regular Section of Land  
1 Mile = 5,280 Ft.**

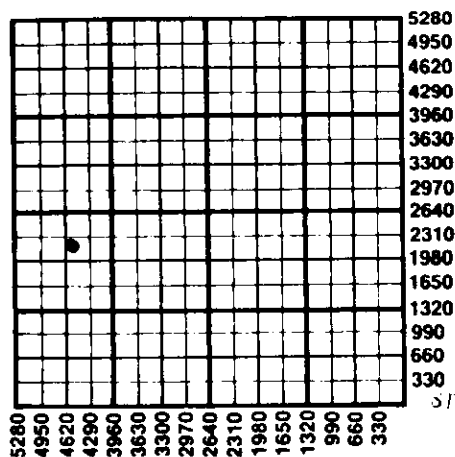

1. Notify District office before setting surface casing.
2. Set surface casing by circulating cement to the top.
3. File completion forms ACO-1 with K.C.C. within 90 days of well completion, following instructions on ACO-1, side 1, and including copies of wireline logs.
4. Notify District office 48 hours prior to old well workover or re-entry.
5. Prior to plugging, prepare a plugging plan, then obtain agreement from the appropriate district office for an approved plugging plan.
6. Submit plugging report (CP-4) to K.C.C. after plugging is completed.
7. Obtain an approved injection docket number before disposing of salt water.
8. Notify K.C.C. within 10 days when injection commences or terminates.
9. If an alternate 2 completion, cement in the production pipe from below any usable water to surface within 120 days of spud date.

STATE CORPORATION COMMISSION OF KANSAS  
CONSERVATION DIVISION

AUG 2 1985  
8-2-85  
CONSERVATION DIVISION  
WICHITA, KANSAS

State Corporation Commission of Kansas  
Conservation Division  
200 Colorado Derby Building  
Wichita, Kansas 67202  
(316) 263-3238