

CARD MUST BE TYPED **CORRECTION OF LOCATION** State of Kansas **NOTICE OF INTENTION TO DRILL**
 (see rules on reverse side)

24c **CORRECTION**
 CARD MUST BE SIGNED
 7-1885

Starting Date: July 15, 1985
 month day year

API Number 15-071-20,368-0000

OPERATOR: License # KCC.#4034
 Name Remuda Corporation
 Address 490 N. 31st Street, Suite 308
 City/State/Zip Billings, Montana 59101
 Contact Person Norm Brown
 Phone (316) 275-0302

East
 NW SW Sec 6 Twp 16 S, Rge 42 West
 (location)
 900 Ft North from Southeast Corner of Section
 4710 Ft West from Southeast Corner of Section
 (Note: Locate well on Section Plat on reverse side)

CONTRACTOR: License # KCC.#6033
 Name Murfin Drilling Co.
 City/State Wichita, Kansas 67202

Nearest lease or unit boundary line 330 feet
 County Greeley
 Lease Name Cheek Well# 3
 Domestic well within 330 feet: yes no
 Municipal well within one mile: yes no

Well Drilled For: Well Class: Type Equipment:
 Oil Swd Infield Mud Rotary
 Gas Inj Pool Ext. Air Rotary
 OWWO Expl Wildcat Cable

Depth to Bottom of fresh water 240 feet
 Lowest usable water formation Dakota
 Depth to Bottom of usable water 1750 feet
 Surface pipe by Alternate: 1 2
 Surface pipe to be set 450 feet
 Conductor pipe if any required _____ feet
 Ground surface elevation 3901 feet MSI
 This Authorization Expires 12-20-85
 Approved By 6-20-85 (RC) **GWR 920 PSL*

If OWWO: old well info as follows:
 Operator _____
 Well Name _____
 Comp Date _____ Old Total Depth _____
 Projected Total Depth 5,300 feet
 Projected Formation at TD Mississippian
 Expected Producing Formations MORROW


I certify that we will comply with K.S.A. 55-101, et seq., plus eventually plugging hole to K.C.C. specifications. Production casing will be cemented immediately upon completion of well from below *
 Date 7-15-85 Signature of Operator or Agent *Edward F. Grotman* Title Vice President

*the usable water to the surface.

Must be filed with the K.C.C. five (5) days prior to commencing well
This card void if drilling not started within six (6) months of date received by K.C.C.

Important procedures to follow :

**A Regular Section of Land
1 Mile = 5,280 Ft.**

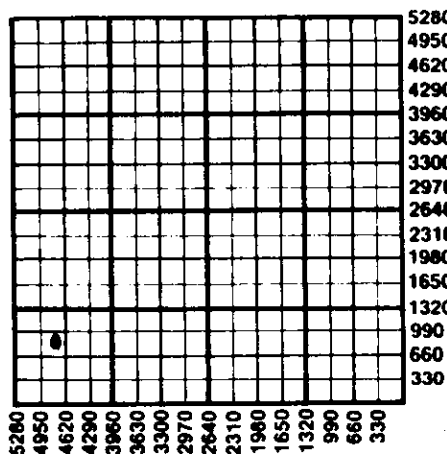

1. Notify District office before setting surface casing.
2. Set surface casing by circulating cement to the top.
3. File completion forms ACO-1 with K.C.C. within 90 days of well completion, following instructions on ACO-1, side 1, and including copies of wireline logs.
4. Notify District office 48 hours prior to old well workover or re-entry.
5. Prior to plugging, prepare a plugging plan, then obtain agreement from the appropriate district office for an approved plugging plan.
6. Submit plugging report (CP-4) to K.C.C. after plugging is completed.
7. Obtain an approved injection docket number before disposing of salt water.
8. Notify K.C.C. within 10 days when injection commences or terminates.
9. If an alternate 2 completion, cement in the production pipe from below any usable water to surface within 120 days of spud date.

State Corporation Commission of Kansas
Conservation Division
200 Colorado Derby Building
Wichita, Kansas 67202
(316) 263-3238

7-18-85