

CARD MUST BE TYPED

State of Kansas

CARD MUST BE SIGNED

NOTICE OF INTENTION TO DRILL

(see rules on reverse side)

Starting Date March 9, 1987
month day yearAPI Number 15— 071-20,436-0000
Approx. SEOPERATOR: License # 9860C. SE. SE. Sec. 27 Twp. 16 S. Rg. 42 X WestName Castle ResourcesAddress RR. #1, Box 90City/State/Zip Hays, KS 67601Contact Person Jerry GreenPhone (913)-625-5155520 Ft. from South Line of Section520 Ft. from East Line of Section

(Note: Locate well on Section Plat on reverse side)

Nearest lease or unit boundary line 520 feetCounty GreeneLease Name Young Well # 1Ground surface elevation Est. 3820 feet MSLDomestic well within 330 feet: yes X noMunicipal well within one mile: yes X noDepth to bottom of fresh water 200Depth to bottom of usable water 1850 1770Surface pipe by Alternate: 1 2 XSurface pipe planned to be set 250'Conductor pipe required N/AProjected Total Depth 5300 feetFormation MississippiCONTRACTOR: License # 8241Name Emphasis Oil OperationsCity/State P.O. Box 506, Russell, KS 67665-0506

Well Drilled For: Well Class: Type Equipment:

X Oil SWD Infield X Mud Rotary Gas Inj Pool Ext. Air Rotary OWWO Expl X Wildcat Cable

If OWWO: old well info as follows:

Operator Well Name Comp Date Old Total Depth

I certify that well will comply with K.S.A. 55-101, et seq., plus eventually plugging hole to KCC specifications. Production string will be immediately cemented from

Date 3-4-87 Signature of Operator or Agent Jerry Green Title President below usable water to surface.

For KCC Use:


Conductor Pipe Required feet; Minimum Surface Pipe Required feet per Alt. 2This Authorization Expires 9-5-87 Approved By 3-5-87Jerry Green

Must be filed with the K.C.C. five (5) days prior to commencing well
This card void if drilling not started within six (6) months of date received by K.C.C.

Important procedures to follow:

1. Notify District office before setting surface casing.
2. Set surface casing by circulating cement to the top.
3. File completion forms ACO-1 with K.C.C. within 90 days of well completion, following instructions on ACO-1, side 1, and including copies of wireline logs.
4. Notify District office 48 hours prior to old well workover or re-entry.
5. Prior to filing Intent, prepare a proposed plugging plan in case well is D & A, then obtain approval of plan when calling district office prior to setting surface pipe.
6. Submit plugging report (CP-4) to K.C.C. after plugging is completed.
7. Obtain an approved injection docket number before disposing of salt water.
8. Notify K.C.C. within 10 days when injection commences or terminates.
9. If an alternate 2 completion, cement in the production pipe from below any usable water to surface within 120 days of spud date.

A Regular Section of Land
1 Mile = 5,280 Ft.

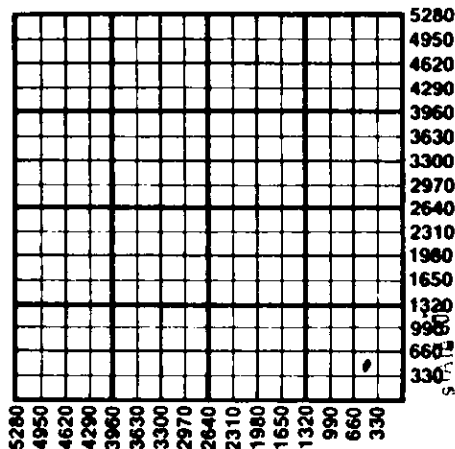

State Corporation Commission of Kansas
Conservation Division
200 Colorado Derby Building
Wichita, Kansas 67202
(316) 263-3238