

NOTICE OF INTENTION TO DRILL

(see rules on reverse side)

OWWO
✓

Expected Spud Date. 11 1 88
month day year

API Number 15-109-20,352-#0001

OPERATOR: License # 5420
Name White & Ellis Drilling, Inc.
Address 401 E. Douglas - Suite 500
City/State/Zip Wichita, KS 67202
Contact Person Michael L. Considine
Phone (316) 263-1102

NE NW SE Sec. 26 Twp. 11 S, Rg. 33 X East West
2310' Ft. from South Line of Section
1650' Ft. from East Line of Section

(Note: Locate well on Section Plat on reverse side)

CONTRACTOR: License # 5420
Name White & Ellis Drilling, Inc.
City/State Wichita, KS 67202

Nearest lease or unit boundary line 330' feet
County Logan
Lease Name Bertrand Well # 65-26 "OWWO"

Well Drilled For: Well Class: Type Equipment:
Oil Storage Infield X Mud Rotary
Gas Inj Pool Ext Air Rotary
X OWWO Expl Wildcat Cable

Ground surface elevation 3092' feet MSL
Domestic well within 330 feet: yes X no
Municipal well within one mile: yes X no
Depth to bottom of fresh water 200' feet
Depth to bottom of usable water ~1900 feet

If OWWO: old well info as follows:
Operator First Energy Corporation
Well Name Bertrand #65-26
Comp Date 9-28-84 Old Total Depth 4700'

Surface pipe by Alternate: 1 2 X
Surface pipe planned to be set 335' feet
Conductor pipe required
Projected Total Depth 4700' feet
Formation Lansing/Kansas City

I certify that well will comply with K.S.A. 55-101, et seq., plus eventually plugging hole to KCC specifications.
Date 10-17-88 Signature of Operator or Agent Michael L. Considine Title Controller

For KCC Use:
Conductor Pipe Required feet; Minimum Surface Pipe Required 335 feet per Alt. X 2
This Authorization Expires 4-26-89 Approved By PCH 10-26-88


EFFECTIVE DATE: 10-31-88

Must be filed with the K.C.C. five (5) days prior to commencing well
This card void if drilling not started within six (6) months of date received by K.C.C.

Important procedures to follow:

1. Notify District office before setting surface casing.
2. Set surface casing by circulating cement to the top.
3. File completion forms ACO-1 with K.C.C. within 120 days of well spud date, following instructions on ACO-1, side 1, and including copies of wireline logs.
4. Notify District office 48 hours prior to old well workover or re-entry.
5. Prior to filing Intent, prepare a proposed plugging plan in case well is D & A, then obtain approval of plan when calling district office prior to setting surface pipe.
6. Submit plugging report (CP-4) to K.C.C. after plugging is completed.
7. Obtain an approved injection docket number before disposing of salt water.
8. Notify K.C.C. within 10 days when injection commences or terminates.
9. If an alternate 2 completion, cement in the production pipe from below any usable water to surface within 120 days of spud date.

**A Regular Section of Land
1 Mile = 5,280 Ft.**

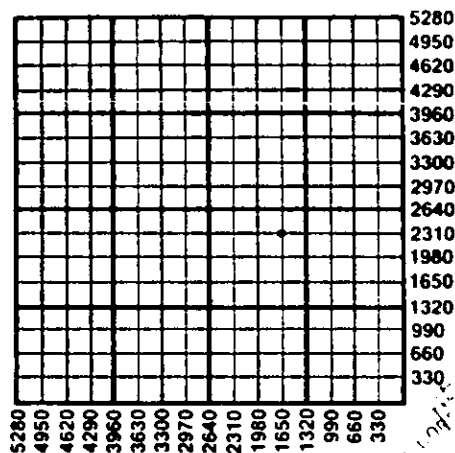

10-26-88

State Corporation Commission of Kansas
Conservation Division
200 Colorado Derby Building
Wichita, Kansas 67202-1212
(316) 263-3238