

CARD MUST BE TYPED

State of Kansas
NOTICE OF INTENTION TO DRILL
(see rules on reverse side)

CARD MUST BE SIGNED

Starting Date: August 26, 1985
month day year

API Number 15-051-24,284-0000

OPERATOR: License # 6518

90!W-NE-SW-SW. See 30 . Twp 11 . S. Rge 19 .
(location) East West

Name Wamego Oil, Inc.

Address P.O. Box 907

City/State/Zip Junction City, Ks. 66441

Contact Person Harold Sadowski

Phone 913-238-8954

990... Ft North from Southeast Corner of Section
~~930-740~~... Ft West from Southeast Corner of Section
(Note: Locate well on Section Plat on reverse side)

CONTRACTOR: License #

Name Unknown

City/State

Well Drilled For: Well Class: Type Equipment:

Oil Swd Infield Mud Rotary

Gas Inj Pool Ext. Air Rotary

OWWO Expl Wildcat Cable

If OWWO: old well info as follows:

Operator N/A

Well Name

Comp Date Old Total Depth

Projected Total Depth 3720 feet

Projected Formation at TD Arbuckle

Expected Producing Formations Arbuckle

Nearest lease or unit boundary line 330 feet.

County Ellis

Lease Name Alibert Well # 2

Domestic well within 330 feet: yes no

Municipal well within one mile: yes no

Depth to Bottom of fresh water 100 feet

Lowest usable water formation Dakota

Depth to Bottom of usable water 800 feet

Surface pipe by Alternate: 1 2

Surface pipe to be set 250 feet

Conductor pipe if any required N/A feet

Ground surface elevation 2055 feet MSL

This Authorization Expires 2-5-86

Approved By 8-5-85

I certify that we will comply with K.S.A. 55-101, et seq., plus eventually plugging hole to K.C.C. specifications.

Date July 31, 1985

Signature of Operator or Agent *Harold Sadowski*


Title Vice President

REH for KADE

Must be filed with the K.C.C. five (5) days prior to commencing well
This card void if drilling not started within six (6) months of date received by K.C.C.

Important procedures to follow :

**A Regular Section of Land
1 Mile = 5,280 Ft.**

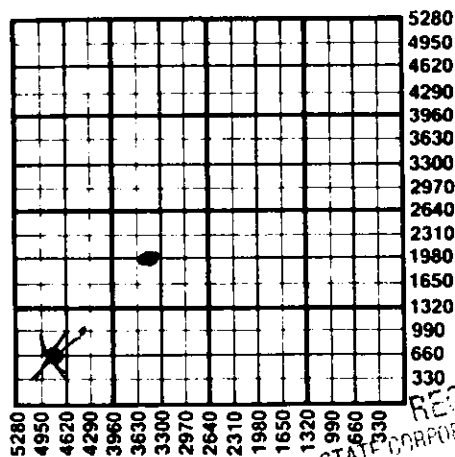

1. Notify District office before setting surface casing.
2. Set surface casing by circulating cement to the top.
3. File completion forms ACO-1 with K.C.C. within 90 days of well completion, following instructions on ACO-1, side 1, and including copies of wireline logs.
4. Notify District office 48 hours prior to old well workover or re-entry.
5. Prior to plugging, prepare a plugging plan, then obtain agreement from the appropriate district office for an approved plugging plan.
6. Submit plugging report (CP-4) to K.C.C. after plugging is completed.
7. Obtain an approved injection docket number before disposing of salt water.
8. Notify K.C.C. within 10 days when injection commences or terminates.
9. If an alternate 2 completion, cement in the production pipe from below and ensure no subsurface water to surface within 120 days of spud date.

RECEIVED
STATE CORPORATION COMMISSION
AUG 5 1985
08-05-85
CONSERVATION DIVISION
Wichita, Kansas

State Corporation Commission of Kansas
Conservation Division
200 Colorado Derby Building
Wichita, Kansas 67202
(316) 263-3238