

STATE OF KANSAS  
STATE CORPORATION COMMISSION

WELL PLUGGING RECORD

Give All Information Completely  
Make Required Affidavit  
Mail or Deliver Report to:  
Conservation Division  
State Corporation Commission  
800 Bitting Building  
Wichita, Kansas

OR  
FORMATION PLUGGING RECORD

Strike out upper line  
when reporting plug-  
ging off formations.

Ellis County, Sec. 30 Twp. 11 Rge. (E) 19 (W)

Location as "NE 1/4 NW 1/4 SW 1/4" or footage from lines. NW, NW, SW

Lease Owner: Darby & Bothwell, Inc.

Lease Name: Mollie Glass Well No. 1

Office Address: 2003 Philtower Building, Tulsa 3, Oklahoma

Character of Well (completed as Oil, Gas or Dry Hole) Dry Hole

Date well completed: March 23, 1946 19.

Application for plugging filed: March 23, 1946 19.

Application for plugging approved: March 23, 1946 19.


Plugging commenced: March 23, 1946 19.

Plugging completed: March 23, 1946 19.

Reason for abandonment of well or producing formation Dry Hole

If a producing well is abandoned, date of last production 19.

Was permission obtained from the Conservation Division or its agents before plugging was com-  
menced? Yes

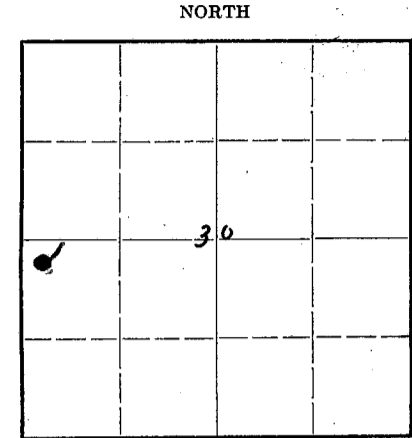

Locate well correctly on above  
Section Plat

Name of Conservation Agent who supervised plugging of this well: H. W. Kerr 3758

Producing formation: None Depth to top: Bottom: Total Depth of Well: 3558 Feet

Show depth and thickness of all water, oil and gas formations.

OIL, GAS OR WATER RECORDS

CASING RECORD

Formation	Content	From	To	Size	Put In	Pulled Out
Arbuckle	None	3723	3758	13-3/8"	159'	None

Describe in detail the manner in which the well was plugged, indicating where the mud fluid was placed and the method or methods used in introducing it into the hold. If cement or other plugs were used, state the character of same and depth placed, from feet to feet for each plug set.

Hole filled with heavy mud to 135'  
Cement plug at 135' - 25 sacks  
Filled with heavy mud to 23'  
Cemented from 23' to top of hole with 15 sacks cement.

**PLUGGING**  
FILE SEC 30-11-R19-U  
BOOK PAGE 7-LINE 35-



(If additional description is necessary, use BACK of this sheet)  
Correspondence regarding this well should be addressed to: Darby & Bothwell, Inc.  
Address: 2003 Philtower Bldg., Tulsa 3, Oklahoma

STATE OF Oklahoma, COUNTY OF Tulsa, ss.  
F. T. Anderson (employee of owner) or (owner or operator) of the above-described well,

being first duly sworn on oath, says: That I have knowledge of the facts, statements, and matters herein contained and the log of the above-described well as filed and that the same are true and correct. So help me God.

(Signature) F. T. Anderson  
2003 Philtower Bldg., Tulsa 3, Okla. (Address)

SUBSCRIBED AND SWORN to before me, this 2nd day of April 1946



J. E. Wailes  
Notary Public.

DRILLING RECORD

15051-014040000

Well No. 1 Molly Glass  
 NW Corner, SW $\frac{1}{4}$ , Sec. 30-11S-19W  
 Ellis County, Kansas

Casing Record

159' of 13 3/8" OD Surface  
 pipe cemented with 100 sax.

Work Commenced 2-28-46  
 Drilling Commenced 3-5-46  
 Drilling Completed 3-23-46  
 Work Completed 3-24-46

No Oil String - Dry Hole

WELL LOG

Surface Clay	0 to 65
Post Rock & Shale	65 to 500
Shale	500 to 545
Sand	545 to 730
Shale & Shells (Sand Streaks)	730 to 940
Red Bed	940 to 980
Sand	980 to 1145
Red Bed	1145 to 1200
Red Bed & Shale	1200 to 1325
Sandy Red Bed	1325 to 1375
Red Bed & Shale	1375 to 1460
Anhydrite	1460 to 1500
Shale	1500 to 1690
Shale & Shells	1690 to 1890
Shale	1890 to 2060
Shale & Lime	2060 to 2140
Shale	2140 to 2310
Shale & Lime	2310 to 2390
Lime	2390 to 2475
Lime & Shale	2475 to 2545
Lime	2545 to 2665
Shale	2665 to 2750
Lime & Shale	2750 to 2890
Shale	2890 to 2975
Shale & Lime	2975 to 3040
Shale	3040 to 3135
Lime & Shale	3135 to 3235
Lime & Shale Breaks	3235 to 3293
Lime	3293 to 3528
Lime & Chert	3528 to 3548
Lime	3548 to 3632
Lime & Little Chert	3632 to 3672
Lime	3672 to 3688
Chertie Conglomerate	3688 to 3691
Lime & Shale (Some Chert)	3691 to 3718
Conglomerate	3718 to 3723
Arbuckle	3723 to 3758

TD - Plugged & Abandoned 3/23/46.

FILE SEC. 30 11-19W  
 PAGE 47 LINE 35

CERTIFICATION

State of Oklahoma, County of Tulsa, SS

I, Herriek Babcock, Partner of Iron Drilling Company, Certify that the accompanying is a true and correct log of the above described well.

Signature

*Herriek Babcock*

Subscribed to and Sworn before me this 3rd day of April, 1946.

*B. Michal*

Notary Public

My commission expires Feb. 28, 1948

