


STATE OF KANSAS
STATE CORPORATION COMMISSION

Form CP-4

WELL PLUGGING RECORD

Give All Information Completely
Make Required Affidavit
Mail or Deliver Report to:
Conservation Division
State Corporation Commission
P. O. Box 17027
Wichita, Kansas 67217
NORTH

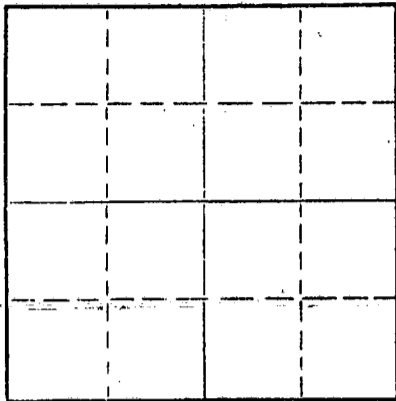

Locate well correctly on above
Section Plat

Ellis County, Sec. 14 Twp. 11 Rge. 19 (E) (W) X
SE/NW/SE

Location as "NE/CNWSW" or footage from lines _____
Lease Owner Chief Drilling Company, Inc.
Lease Name Devine Well No. 1
Office Address 905 Century Plaza Wichita, Kansas 67202
Character of Well (completed as Oil, Gas or Dry Hole) _____
Date well completed _____ 19____
Application for plugging filed _____ 19____
Application for plugging approved _____ 19____
Plugging commenced October 7, 1972
Plugging completed October 18, 1972
Reason for abandonment of well or producing formation Depleted

If a producing well is abandoned, date of last production _____ 19____
Was permission obtained from the Conservation Division or its agents before plugging was commenced? Yes

Name of Conservation Agent who supervised plugging of this well Leo Massey
Producing formation _____ Depth to top _____ Bottom _____ Total Depth of Well 3452 Feet
Show depth and thickness of all water, oil and gas formations.

OIL, GAS OR WATER RECORDS

CASING RECORD

FORMATION	CONTENT	FROM	TO	SIZE	PUT IN	PULLED OUT
				8 5/8	200	None
				5 1/2	3449 1/2	270'


Describe in detail the manner in which the well was plugged, indicating where the mud fluid was placed and the method or methods used in introducing it into the hole. If cement or other plugs were used, state the character of same and depth placed, from _____ feet to _____ feet for each plug set.

Measured T.D. at 3409'. Pushed a plug to 3160' and dumped 5 sacks cement.
Shot casing at 331 and 270 feet. Pulled a total of 9 joints of 5 1/2" casing.
Squeezed well with 10 sacks gel and 100 sacks cement.

RECEIVED
STATE CORPORATION COMMISSION
OCT 30 1972
CONSERVATION DIVISION
Wichita, Kansas

(If additional description is necessary, use BACK of this sheet)
Name of Plugging Contractor Rockhold Engineering, Inc.
Address P. O. Box 698 Great Bend, Kansas 67530

STATE OF Kansas, COUNTY OF Barton, ss.
James W. Rockhold (employee of owner) or (owner or operator) of the above-described well, being first duly sworn on oath, says: That I have knowledge of the facts, statements, and matters herein contained and the log of the above-described well as filed and that the same are true and correct. So help me God.

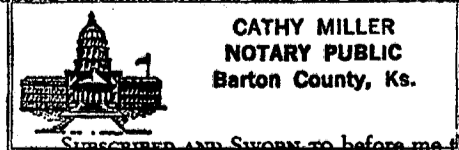

(Signature) James W. Rockhold
Box 698 Great Bend, Ks. 67530 James W. Rockhold
(Address)

27th day of October, 1972

Cathy Miller
Cathy Miller, Notary Public.

My commission expires September 30, 1975

15-051-01517-0000

RECEIVED
STATE CORPORATION COMMISSION
AUG 11 1972

CONSERVATION DIVISION
Topeka, Kansas

WELL LOG

Chief Drilling Co., Inc.
Box 797
Great Bend, Kansas

DEVINE #1
SE NW SE Sec. 14-11S-19W
Ellis County, Kansas

Contractor: Chief Drilling Co., Inc.

Commenced: 2/27/64
Completed: 3/11/64

Casing Record: 8-5/8" @ 200' w/200 sacks Sunset Cement & 2 sacks Gel
5-1/2" @ 3449 1/2' w/100 sacks Salt Saturated Cement

<u>FORMATION</u>	<u>FROM</u>	<u>TO</u>	<u>ELEVATION</u>		
			1928 Gr.		
			1930 D.F.		
			1933 K.B.		
				<u>FORMATION TOPS</u>	
Shale	0	490			
Sand	490	600			
Shale & Shells	600	760			
Salt & Sand	760	940			
Shale, Shells & Red Bed	940	1267			
Anhydrite	1267	1295		<u>Sample</u>	<u>Log</u>
Shale & Shells	1295	1650		Anhydrite	1267 + 666 1268 + 665
Lime & Shale	1650	2230		Topeka Lime	2891 - 958 2891 - 958
Lime	2230	2390		Heebner Shale	3115 - 1182 3115 - 1182
Shale & Lime	2390	2891		Toronto Lime	3137 - 1204 3135 - 1202
Lime	2891	3115		Lansing-KC	3154 - 1221 3156 - 1223
Lime & Shale	3115	3154		Base Kansas City	3376 - 1443 3375 - 1442
Lime	3154	3376		Conglomerate	3391 - 1458 3391 - 1458
Shale & Lime	3376	3391		Simpson Shale	3422 - 1489 3424 - 1491
Conglomerate	3391	3422		Simpson Dolomite	3432 - 1499 3432 - 1499
Shale	3422	3432		Arbuckle	3449 - 1516 3449 - 1516
Dolomite	3432	3452		Total Depth	3452 - 1519 3452 - 1519
Total Depth	3452				

STATE OF KANSAS, COUNTY OF BARTON) SS

I hereby certify that the above is a true and correct copy of the Driller's Log of the well drilled in the SE NW SE Sec. 14-11S-19W, Ellis County, Kansas, to the best of my knowledge and belief.

CHIEF DRILLING CO., INC.

V. Richard Hoover
V. Richard Hoover, President

Subscribed and sworn to before me this 18th day of March, 1964.

Carmen R. Cook
Carmen R. Cook, Notary Public

My commission expires: Jan. 26, 1967