


STATE OF KANSAS
STATE CORPORATION COMMISSION

WELL PLUGGING RECORD

Give Full Information Completely
Make Required Affidavit
Mail or Deliver Report to:
Conservation Division
State Corporation Commission
800 Bittling Building
Wichita, Kansas

NORTH

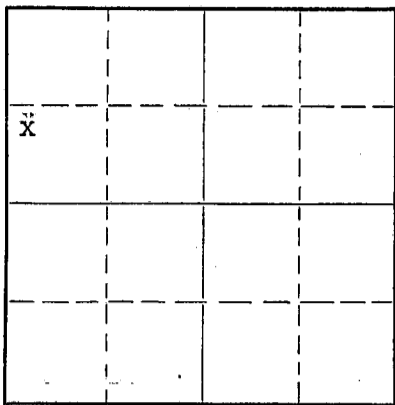

Locate well correctly on above
Section Flat

Ellis County. Sec. 12 Twp. 11 Rge. 19 (E) W (W)
Location as "NE/CNW $\frac{1}{4}$ SW $\frac{1}{4}$ " or footage from lines NW SW NW
Lease Owner V. D. Sidey
Lease Name Gasaway B#1 Well No. 1
Office Address Russell, Kansas
Character of Well (completed as Oil, Gas or Dry Hole) Dry
Date well completed 1-30 1952
Application for plugging filed 1-23 1952
Application for plugging approved 1-23 1952
Plugging commenced 1-24 1952
Plugging completed 1-30 1952
Reason for abandonment of well or producing formation Dry

If a producing well is abandoned, date of last production 19
Was permission obtained from the Conservation Division or its agents before plugging was commenced? Yes

Name of Conservation Agent who supervised plugging of this well Eldon Petty
Producing formation Depth to top Bottom Total Depth of Well 3622 Feet
Show depth and thickness of all water, oil and gas formations.

OIL, GAS OR WATER RECORDS

CASING RECORD

Formation	Content	From	To	Size	Put In	Pulled Out
				8 5/8"	110'	-
				5 1/2"	3730' 9"	3210'

Describe in detail the manner in which the well was plugged, indicating where the mud fluid was placed and the method or methods used in introducing it into the hole. If cement or other plugs were used, state the character of same and depth placed, from feet to feet for each plug set.

Ripped at 3268' shot off at 3185' pulled pipe-mudded up to 233' set rock bridge and dumped 15 sacks cement mudded to 35' set rock bridge and dumped 10 sacks of cement.

(If additional description is necessary, use BACK of this sheet)

Correspondence regarding this well should be addressed to V. D. Sidey
Address Russell, Kansas

STATE OF Kansas, COUNTY OF Russell, ss.


(employee of owner) or (owner or operator) of the above-described well, being first duly sworn on oath, says: That I have knowledge of the facts, statements, and matters herein contained and the log of the above-described well as filed and that the same are true and correct. So help me God.

(Signature) *V. D. Sidey*
Russell, Kansas
(Address)

SUBSCRIBED AND SWORN to before me this 19th day of February, 1952

My commission expires April 19, 1954

Mary Ellen Cummings
Notary Public.

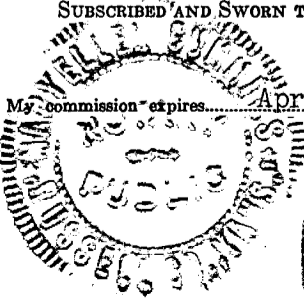

PLUGGING
FILE SEC-12-T-11-R-1952
BOOK PAGE 142 LINE 3

SIDEY DRILLING COMPANY

BUILDING & LOAN BLDG. P. O. BOX 387

RUSSELL, KANSAS

COMPANY V. D. Sidey Oil Company

SEC. 12 T. 11 R. 19
LOC. NW SW NW

FARM Gasaway B #1

NO. #1

TOTAL DEPTH
COMM. 10-24-51
SHOT OR TREATED
CONTRACTOR
ISSUED

COMP. 1-30-52

COUNTY Ellis

	CASING	
20	10	
15½	8¾	110'
12½	6%	
13%	5 5/16	3730' 9"

ELEVATION 2073 G. L.

PRODUCTION D. A.

FIGURES INDICATE BOTTOM OF FORMATIONS

285	shale and shells
410	shale and shells
420	sand
570	white chalk and shale
695	sand
745	shale and shells
760	sand and shale
820	shale and shells
1110	sand
1385	shale and shells
1416	shale and red rock
1416-	
1450	anhydrite
1510	shale and shells
1680	shale and shells
1890	shale and shells
2015	shale and lime
2145	lime
2255	lime and shale
2300	lime
2335	lime and shale
3215	lime
3326	lime and shale
3340	lime
3595	lime and shale
3622	lime and shale

T. D.

STATE OF KANSAS)
COUNTY OF RUSSELL) SS.

I, V. D. Sidey, of the Sidey Drilling Company, upon oath state that the above and foregoing is a true and correct copy of the log of the Gasaway B #1 well.

V. D. Sidey

V. D. Sidey

Subscribed and sworn to before me this 19th. day of February, 1952.

Walter Cummins

Notary Public

My Commission Expires: April 19, 1954