


STATE OF KANSAS
STATE CORPORATION COMMISSION
Give All Information Completely
Make Required Affidavit
Mail or Deliver Report to:
Conservation Division
State Corporation Commission
800 Bittling Building
Wichita, Kansas

WELL PLUGGING RECORD

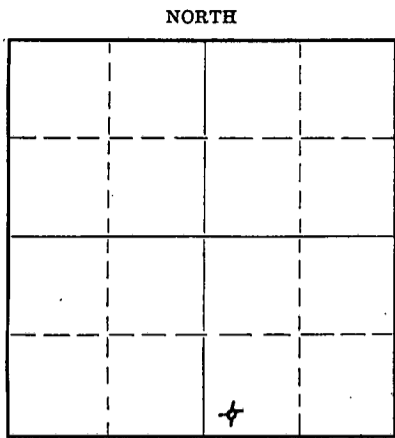

Locate well correctly on above Section Flat

Ellis County Sec. 7 Twp. 11S Rge. 19 ^W~~SW~~ (H)
 Location as "NE/CNW $\frac{1}{4}$ SW $\frac{1}{4}$ " or footage from lines SW SW SE
 Lease Owner Peel-Hardman
 Lease Name Glinther Well No. 1
 Office Address P. O. Box 359, Hoisington, Kansas
 Character of Well (completed as Oil, Gas or Dry Hole) Dry Hole
 Date well completed May 27 1950
 Application for plugging filed May 27 1950
 Application for plugging approved May 27 1950
 Plugging commenced May 27 1950
 Plugging completed May 27 1950
 Reason for abandonment of well or producing formation Dry Hole

If a producing well is abandoned, date of last production 19
 Was permission obtained from the Conservation Division or its agents before plugging was commenced? Yes

Name of Conservation Agent who supervised plugging of this well E. R. Petty
 Producing formation Depth to top Bottom Total Depth of Well 3748 Feet
 Show depth and thickness of all water, oil and gas formations.

OIL, GAS OR WATER RECORDS

CASING RECORD

Formation	Content	From	To	Size	Put In	Pulled Out
		0	154	8 5/8	154	None

Describe in detail the manner in which the well was plugged, indicating where the mud fluid was placed and the method or methods used in introducing it into the hole. If cement or other plugs were used, state the character of same and depth placed, from feet to feet for each plug set.

- 3748' - 151 1/2' - Heavy Rotary Mud
- 151 1/2' - 150' - Wooden Plug
- 150' - 104' - 15 sacks cement
- 104' - 36 1/2' - Heavy Rotary Mud
- 36 1/2' - 35' - Wooden Plug
- 35' - 6' - 10 sacks cement
- 6' - Surface - Cellar

6-8-50
 JUN 8 1950
 STATE CORPORATION COMMISSION
 KANSAS

(If additional description is necessary, use BACK of this sheet)

Correspondence regarding this well should be addressed to Peel-Hardman
 Address P. O. Box 359, Hoisington, Kansas

STATE OF Kansas, COUNTY OF Barton, ss.
 Glenn Peel Drilling Co., Inc. (employee of owner) or (owner or operator) of the above-described well,
 being first duly sworn on oath, says: That I have knowledge of the facts, statements, and matters herein contained and the log of the above-described well as filed and that the same are true and correct. So help me God. GLENN PEEL DRILLING COMPANY, INC.

(Signature) BY: *Glenn Peel*
 P. O. Box 359, Hoisington, Kansas (Address)



SUBSCRIBED AND SWORN to before me this 7th day of June, 1950
 My commission expires June 4, 1951
 Marion M. Herby Notary Public.

22-7877-s 4-49-10M
 PLUG
 FILE SEC-711-R19W
 BOOK PAGE-8 LINE-37

DRILLER'S LOG

Company: Peel-Hardman

Sec. 7 Twp. 11S Rge. 19W
SW SW SE

Farm: Günther Well No. 1

Total Depth: 3748'

County: Ellis,
Kansas

Comm.: 5-14-50 Comp.: 5-27-50
Contractor: Glenn Peel Drilling Co., Inc.

Elevation:

Casing:
8 5/8" 154' cem.

Production: Dry

Figures below indicate bottom of formations

Surface Clay	0 -	21
Shale		57
Sand		96
Shale		482
Sand		517
Shale and Shells		1021
Sand		1208
Sand and Shale		1255
Shale and Shells		1330
Shales and Red Bed		1540
Anhydrite		1581
Shale and Shells		2115
Shale and Lime		2250
Lime	Geological Tops	2497
Lime and Shale	Measured from Rotary Bushing	2509
Shale	Top Topeka - 3143	2616
Lime and Shale	Top Heebner - 3361	2755
Shale	Top Lans.-K.C. - 3407	2880
Lime and Shale	Top Cherty Congl. - 3666	2980
Shale	Top Simpson Shale - 3697	3087
Lime and Shale	Top Arb. Dolomite - 3718	3145
Shale		3178
Lime		3237
Lime and Shale		3325
Lime		3358
Lime and Shale		3404
Lime and Chert		3680
Shale and Lime		3699
Arbuckle		3748
Dolomite		
Total Depth		3748

RECEIVED
Conservation Div.
JUN 8 X 1950
STATE CORPORATION
COMMISSION
KANSAS

This is to certify that the above information is, to the best of our knowledge, true and correct.

GLENN PEEL DRILLING COMPANY, INC.

BY: J.P. [Signature]

SUBSCRIBED AND SWORN to before me this 7th day of June, 1950.

My commission expires June 4, 1951, Marion M. Herber
Notary Public



PLUGGING
FILE SEC-7-T-11-R-19W
BOOK PAGE 8 LINE 37