

CARD MUST BE TYPED

State of Kansas

CARD MUST BE SIGNED

NOTICE OF INTENTION TO DRILL

(see rules on reverse side)

Starting Date November 17, 1986
month day year

API Number 15- 165-21,368-0000

OPERATOR: License # 6569
Name C. & C. Exploration Inc.
Address 14 Circle Drive
City/State/Zip Beloit KS 67420
Contact Person Carmen Schmitt
Phone 913-738-3210

W/2 SE SW Sec. 31 Twp. 16 S, Rg. 20 ~~East~~ West
660 Ft. from South Line of Section
3630 Ft. from East Line of Section

(Note: Locate well on Section Plat on reverse side)

CONTRACTOR: License #
Name
City/State

Nearest lease or unit boundary line 660 feet
County Rush
Lease Name North Well # 1

Well Drilled For: Well Class: Type Equipment:
 Oil SWD Infield Mud Rotary
~~Gas Inj Pool Ext Air Rotary~~
 OWWO Expl Wildcat Cable

Ground surface elevation ast 2170 feet MSL
Domestic well within 330 feet: yes no
Municipal well within one mile: yes no
Depth to bottom of fresh water 120 ft.
Depth to bottom of usable water 650 600 ft.

If OWWO: old well info as follows:

Operator
Well Name
Comp Date Old Total Depth

Surface pipe by Alternate: 1 2 XX
Surface pipe planned to be set 220 ft.
Conductor pipe required
Projected Total Depth 4300 feet
Formation Arbuckle

I certify that well will comply with K.S.A. 55-101, et seq., plus eventually plugging hole to KCC specifications.

Date 11-17-86 Signature of Operator or Agent Carmen Schmitt Title President

For KCC Use:

Conductor Pipe Required _____ feet; Minimum Surface Pipe Required 200 feet per Alt. F 2
This Authorization Expires 5-5-87 Approved By 11-5-86

RCC/KCC
see tab.


Municipal well
1 1/4 miles SE
2

Must be filed with the K.C.C. five (5) days prior to commencing well
This card void if drilling not started within six (6) months of date received by K.C.C.

Important procedures to follow:

1. Notify District office before setting surface casing.
2. Set surface casing by circulating cement to the top.
3. File completion forms ACO-1 with K.C.C. within 90 days of well completion, following instructions on ACO-1, side 1, and including copies of wireline logs.
4. Notify District office 48 hours prior to old well workover or re-entry.
5. Prior to filing Intent, prepare a proposed plugging plan in case well is D & A, then obtain approval of plan when calling district office prior to setting surface pipe.
6. Submit plugging report (CP-4) to K.C.C. after plugging is completed.
7. Obtain an approved injection docket number before disposing of salt water.
8. Notify K.C.C. within 10 days when injection commences or terminates.
9. If an alternate 2 completion, cement in the production pipe from below any usable water to surface within 120 days of spud date.

A Regular Section of Land
1 Mile = 5,280 Ft.

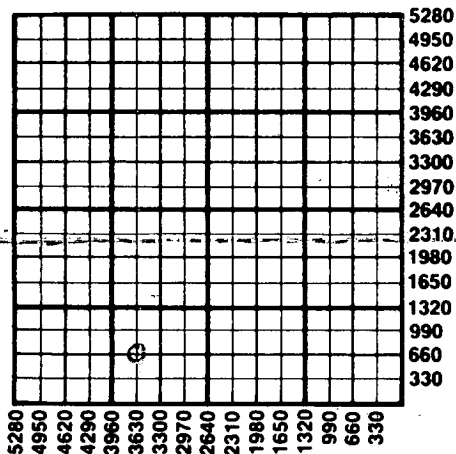

NOV 5 1986

State Corporation Commission of Kansas
Conservation Division
200 Colorado Derby Building
Wichita, Kansas 67202
(316) 263-3238