

STATE CORPORATION COMMISSION OF KANSAS
OIL & GAS CONSERVATION DIVISION

WELL COMPLETION OR RECOMPLETION FORM
ACO-1 WELL HISTORY

DESCRIPTION OF WELL AND LEASE

Operator: License # 4087
Name Williamson Drilling, Inc.
Address 5501 Navajo
City/State/Zip Great Bend, Ks. 67530

Purchaser

Operator Contact Person Terry L. Williamson
Phone 316-793-8229

Contractor: License # 4087
Name Williamson Drilling, Inc.

Wellsite Geologist Ron Nelson
Phone 913-625-3550

Designate Type of Completion

New Well Re-Entry Workover

Oil SWD Temp Abd
 Gas Inj Delayed Comp.
 Dry Other (Core, Water Supply etc.)

If OWWO: old well info as follows:

Operator
Well Name
Comp. Date Old Total Depth

WELL HISTORY

Drilling Method:

Mud Rotary Air Rotary Cable

12-12-85 12-19-85 12-19-85
Spud Date Date Reached TD Completion Date

3900
Total Depth PBTD

Amount of Surface Pipe Set and Cemented at 252 feet
Multiple Stage Cementing Collar Used? Yes No
If yes, show depth set feet

If alternate 2 completion, cement circulated
from feet depth to w/SX cmt

API NO. 15-165-21.344-0000

County Rush
165' E of
NW NE SW Sec 29 Twp 16 Rge 19 East West

2310 Ft North from Southeast Corner of Section
3465 Ft West from Southeast Corner of Section
(Note: Locate well in section plat below)


Lease Name Krug 'A' Well # 1

Field Name Hampton SE

Producing Formation

Elevation: Ground 2061 KB 2066

Section Plat

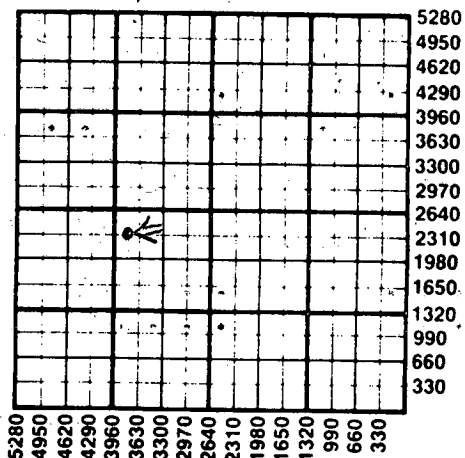

WATER SUPPLY INFORMATION

Disposition of Produced Water: Disposal Repressuring
Docket #

Questions on this portion of the ACO-1 call:

Water Resources Board (913) 296-3717

Source of Water:
Division of Water Resources Permit # Farm Pond

Groundwater Ft North from Southeast Corner (Well) Ft West from Southeast Corner of Sec Twp Rge East West

Surface Water 2000 Ft North from Southeast Corner (Stream, pond etc) 3600 Ft West from Southeast Corner Sec 29 Twp 16 Rge 19 East West

Other (explain) (purchased from city, R.W.D. #)

INSTRUCTIONS: This form shall be completed in duplicate and filed with the Kansas Corporation Commission, 200 Colorado Derby Building, Wichita, Kansas 67202, within 90 days after completion or recompletion of any well. Rule 82-3-130 and 82-3-107 apply.

Information on side two of this form will be held confidential for a period of 12 months if requested in writing and submitted with the form. See rule 82-3-107 for confidentiality in excess of 12 months. One copy of all wireline logs and drillers time log shall be attached with this form. Submit CP-4 form with all plugged wells. Submit CP-111 form with all temporarily abandoned wells.

All requirements of the statutes, rules and regulations promulgated to regulate the oil and gas industry have been fully complied with and the statements herein are complete and correct to the best of my knowledge.

Signature Terry L. Williamson

Title President-Williamson Drilling Inc Date 12-26-85

Subscribed and sworn to before me this 26 day of December 1985

Notary Public Kim Williamson

Date Commission Expires 12-20-88



K.C.C. OFFICE USE ONLY
F Letter of Confidentiality Attached
C Wireline Log Received
C Drillers Timelog Received
Distribution
 KCC SWD/Rep NGPA
 KGS Plug Other
(Specify)
RECEIVED
STATE CORPORATION COMMISSION

Form ACO-1 (7-84)
DEC 30 1985

Sec 29 Twp 16 Rge 19

