

This form shall be filed in duplicate with the Kansas Corporation Commission, 200 Colorado Derby Building, Wichita, Kansas 67202, within ten days after the completion of the well, regardless of how the well was completed.

Attach separate letter of request if the information is to be held confidential. If confidential, only file one copy. Information on side one will be of public record and side two will then be held confidential.

Circle one: Oil, Gas, Dry, SWD, OWWO, Injection. Type and complete ALL sections. Applications must be filed for dual completion, commingling, SWD and injection, T.A.

Attach wireline logs (i.e. electrical log, sonic log, gamma ray neutron log, etc.). KCC # (316) 263-3238. (Rules 82-2-105 & 82-2-125)

OPERATOR Pickrell Drilling Company

API NO. None 15-135-19049-0000

ADDRESS 110 N. Market, Suite 205
Wichita, Kansas 67202

COUNTY Ness
FIELD

**CONTACT PERSON Jack Gurley
PHONE (316) 262-8427

PROD. FORMATION Miss

PURCHASER Getty

LEASE Moore


ADDRESS P. O. Box 3000
Tulsa, OK 74102

WELL NO. 2

DRILLING CONTRACTOR Pickrell Drilling Company
ADDRESS 110 N. Market, Suite 205
Wichita, Kansas 67202

WELL LOCATION C NW NW
660 Ft. from North Line and
660 Ft. from West Line of
the NW/4SEC. 7 TWP. 20 RGE. 21W

WELL PLAT

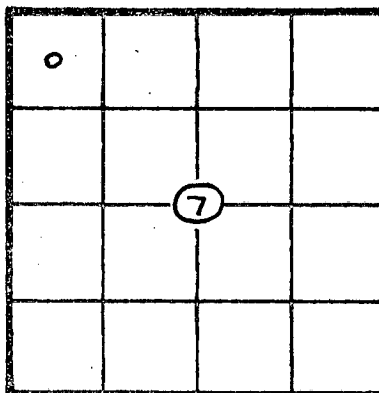

KCC _____
KGS _____
(Office Use)

PLUGGING CONTRACTOR Kelso Casing Pulling
ADDRESS P. O. Box 176
Chase, Kansas 67524

TOTAL DEPTH 4368' (Deepened later to 4377')
PBD

SPUD DATE 3-19-64 DATE COMPLETED 3-30-64

ELEV: GR 2226' DF 2228' KB 2231'

DRILLED WITH (CABLE) (ROTARY) (TWT) TOOLS

Amount of surface pipe set and cemented 8 5/8" at 318' w/275sx DV Tool Used? No

AFFIDAVIT

STATE OF Kansas, COUNTY OF Sedgwick SS, I,

C. W. Sebitts OF LAWFUL AGE, BEING FIRST DULY SWORN UPON HIS OATH,

DEPOSES THAT HE IS Attorney-in-Fact (FOR) Pickrell Drilling Company

OPERATOR OF THE Moore LEASE, AND IS DULY AUTHORIZED TO MAKE

THIS AFFIDAVIT FOR AND ON THE BEHALF OF SAID OPERATOR, THAT WELL NO. 2 ON

SAID LEASE HAS BEEN COMPLETED AS OF THE 30th DAY OF March, 19 64, AND THAT

ALL INFORMATION ENTERED HEREIN WITH RESPECT TO SAID WELL IS TRUE AND CORRECT.

FURTHER AFFIANT SAITH NOT.

(S) [Signature] C. W. Sebitts

SUBSCRIBED AND SWORN BEFORE ME THIS 7th DAY OF June, 19 82

BRENDA A. BALDWIN
STATE NOTARY PUBLIC
Sedgwick County, Kansas
My Appt. Expires 6-29-82

[Signature] NOTARY PUBLIC
Brenda A. Baldwin

MY COMMISSION EXPIRES:

**The person who can be reached by phone regarding any questions concerning this information. Within 45 days of completion, a witnessed initial test by the Commission is required if the well produces more than 25 BOPD or is located in a Basic Order Pool.

SIDE TWO

WELL LOG

Show all important zones of porosity and contents thereof; cored intervals, and all drill-stem tests, including depth interval tested, cushion used, time tool open, flowing and shut-in pressures, and recoveries.

SHOW GEOLOGICAL MARKERS, LOGS RUN, OR OTHER DESCRIPTIVE INFORMATION.

FORMATION DESCRIPTION, CONTENTS, ETC.	TOP	BOTTOM	NAME	DEPTH
DST #1, 4262'-4301', Tool open 1 hr wk blow for 7", flush at 30" no inc. Rec. 20' mud w/few specks of oil, IBHP 1338#, FBHP 109#, FP 31/39#, HP 2258/2242#.			Sample Tops: Anhydrite Heebner Toronto Lansing/KC B/Kansas City Marmaton Pawnee Fort Scott Mississippian	1448(+783) 3720(-1489) 3742(-1511) 3768(-1537) 4096(-1865) 4119(-1888) 4193(-1962) 4273(-2042) 4348(-2117)
DST #2, 4326'-4358', Tool op 45" with wk blow for 5", flush at 20", no inc. Rec. 10' mud w/few specks of oil, IBHP 553#, FBHP 116#, FP 23/31#, HP 2322/2290#.				
DST #3, 4358'-4368', Tool op 2 hrs w/initial fair blow building to str blow in 12". Rec. 310' GIP, 620' total fluid, 372' cln gassy oil, 248' mdy oil, IBHP 1386#, FBHP 1362#, FP 101/233#, HP 2290/2290#.				

Report of all strings set — surface, intermediate, production, etc. CASING RECORD (New) or (Used)

Purpose of string	Size hole drilled	Size casing set (in O.D.)	Weight lbs/ft.	Setting depth	Type cement	Sacks	Type and percent additives
Surface		8 5/8"		318'		275	
Production		5 1/2"	15.5#	4358'		100	

LINER RECORD

PERFORATION RECORD

Top, ft.	Bottom, ft.	Sacks cement	Shots per ft.	Size & type	Depth interval
TUBING RECORD			OPEN HOLE ----- 4358'-4377'		
Size	Setting depth	Packer set at			

ACID, FRACTURE, SHOT, CEMENT SQUEEZE RECORD

Amount and kind of material used	Depth interval treated
No treatment - natural.	4358'-4377'

Date of first production 4-11-64	Producing method (flowing, pumping, gas lift, etc.) Pumping	Gravity
RATE OF PRODUCTION PER 24 HOURS	Oil 112 BOPD bbls.	Gas MCF
	Water % None bbls.	Gas-oil ratio CFPB
Disposition of gas (vented, used on lease or sold)		Perforations None - Open hole

BAKER SERVICE TOOLS - TALLY PAD

15-135-19049-0000

New Completion Workover

Oil Company Pickrell Well No. 2 Field Schaben Lease Moore
 Company Man _____ Date Drilled 1964 County Ness State Kansas

JT. NO.	FT.	100 THS	JT. NO.	FT.	100 THS	JT. NO.	FT.	100 THS	JT. NO.	FT.	100 THS
1											
2											
Total											

- 318' Base 8 5/8" w/ 275 Sx

- 3780 ESTIMATED T.O.C.

- 4358 Base 5 1/2" 15.5 # w/ 100 Sx

- 4377 T.D. (Cable Tools)

REMARKS:

Totals this page _____

Average jt. lgth. this page _____

Date of Tally _____

No. Jts. on Location _____

Tbg. Sz. _____ Thd. _____ Wt. _____ Gr. _____

Csg. Sz. _____ Wt. _____ Gr. _____




BAKER SERVICE TOOLS—WELL RECORD

CHECK TOOLS LEFT IN WELL



Model "R"
Upstrain Unloading Sub
Product No. 675-05

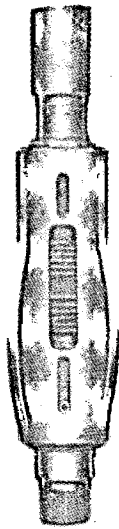

Model "B-2"
Tubing Anchor-Catcher
Product No. 698-03



Model "L"
Lok-Set Retrieving Head
Product No. 677-75



Model "H"
Washover Type Retrieving Head
Product No. 677-71



Model "M"
Retrieving Head
Product No. 677-76



Model "C"
Full-Bore Retrievable Cementer
Product No. 410-01
Size



Model "EA"
Retrievamatic Cementer
Product No. 407-05
Size



Model "C-3"
Roto-Vert Casing Scraper
Product No. 620-03
Size



Model "G" Lok-Set
Retrievable Bridge Plug
Product No. 677-34
Size



Model "C"
Retrievable Bridge Plug
Product No. 677-01
Size



Wire Line Set
Retrievable Bridge Plug
Product No. 677-32
Size