

WELL PLUGGING RECORD

Give All Information Completely
Make Required Affidavit
Mail or Deliver Report to
Conservation Division
State Corporation Comm.
200 Colorado Derby Bldg.
202 W. 1st St.
Wichita, KS 67202

Ellis County Sec. 30 Twp. 11S Rge. 19W
Location as "NE/CNW/SW" or footage from lines _____

Lease Owner Wamego Oil, Inc.
Lease Name Allbert 120 Well No. #1

Office Address P.O. Box 907 Junction City, Ks

Character of Well (Completed as Oil, Gas or Dry Hole) 6641
Dry Hole

Date Well completed 11-18 1983
Application for plugging filed 11-18 1983
Application for plugging approved 11-18 1983
Plugging commenced 2:00 P.M. 11-18 1983
Plugging completed 6:15 P.M. 11-18 1983


Reason for abandonment of well or producing formation No Commercial Production

If a producing well is abandoned, date of last production _____ 19____

Was permission obtained from the Conservation Division or its agents before plugging was commenced? Yes
Name of Conservation Agent who supervised plugging of this well Marion Schmidt

Producing formation _____ Depth to top _____ Bottom _____ Tl. Depth of Well _____
Show depth and thickness of all water, oil and gas formations.

locate well correctly
on above
Section Plot

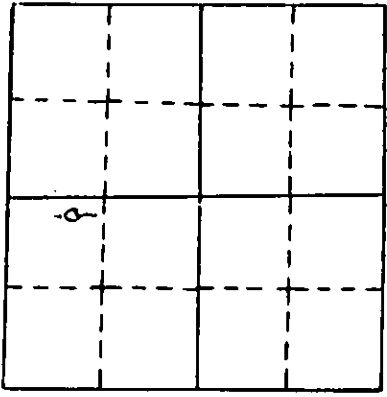

OIL, GAS OR WATER RECORDS CASING RECORD

FORMATION	CONTENT	FROM	TO	SIZE	PUT IN	PULLED OUT
Surface Casing	60-40pos	0'	259'	8 5/8"	259'	0'

Describe in detail the manner in which the well was plugged, indicating where the mud fluid was placed and the method or methods used in introducing it into the hold. If cement or other plugs were used, state the character of same and depth placed, from _____ feet to _____ feet for each plug set.

1-11-88

- Plug #1 3750' with 20sxs
- Plug #2 1500' with 20sxs
- Plug #3 750' with 100sxs
- Plug #4 270' with 40sxs
- Plug #5 40' with 10sxs
- TOTAL ----- 10sxs in rat hole
200sxs 50-50pos 4%gel 3%cc

P.D. @ 6:15 P.M. 11-18-83

(If additional description is necessary, use BACK of this sheet)

Name of Plugging Contractor Pioneer Drilling Company
308 West Mill Plainville, Ks 67663