


WELL PLUGGING RECORD

Give All Information Completely  
Make Required Affidavit  
Mail or Deliver Report to:  
Conservation Division  
State Corporation Commission  
800 Bittling Building  
Wichita, Kansas

NORTH

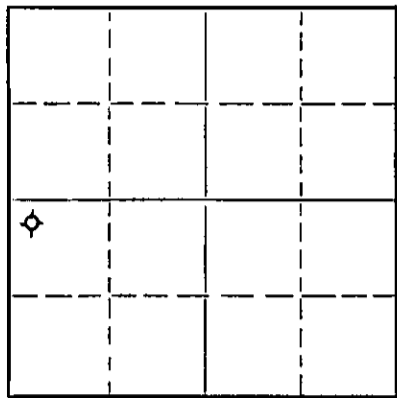

Locate well correctly on above Section Flat

Ellis County. Sec. 35 Twp. 11 Rge. 19 (E) W (W)  
Location as "NE/CNW $\frac{1}{4}$ /SW $\frac{1}{4}$ " or footage from lines NW, NW SW  
Lease Owner C-G DRILLING CO.  
Lease Name JENSEN Well No. I  
Office Address 544 Petroleum Bldg, Wichita, Kansas  
Character of Well (completed as Oil, Gas or Dry Hole) Dry Hole  
Date well completed March 3, 19 53  
Application for plugging filed March 3, 19 53  
Application for plugging approved March 3, 19 53  
Plugging commenced March 3, 19 53  
Plugging completed March 3, 19 53  
Reason for abandonment of well or producing formation too low structurally.

If a producing well is abandoned, date of last production 19  
Was permission obtained from the Conservation Division or its agents before plugging was commenced? yes

Name of Conservation Agent who supervised plugging of this well Elson Petty  
Producing formation Depth to top Bottom Total Depth of Well 3746 Feet  
Show depth and thickness of all water, oil and gas formations.

OIL, GAS OR WATER RECORDS

CASING RECORD

Formation	Content	From	To	Size	Put In	Pulled Out
				8 5/8"	173'	

Describe in detail the manner in which the well was plugged, indicating where the mud fluid was placed and the method or methods used in introducing it into the hole. If cement or other plugs were used, state the character of same and depth placed, from feet to feet for each plug set.

Filled hole with mud to 165'; set plug; 1/2 sack hulls, 15 sacks cement. Filled hole with mud to 40'; set plug, then filled to top with 10 sacks cement and 1/2 sack hulls.

(If additional description is necessary, use BACK of this sheet)  
Name of Plugging Contractor LOHMANN-JOHNSON DRILLING COMPANY, INC.  
Address 320 Indiana Bank Bldg., Evansville 8, Indiana

STATE OF KANSAS, COUNTY OF SEDGWICK, ss.  
Vicky Jacobs (employee of owner) or (owner or operator) of the above-described well,  
being first duly sworn on oath, says: That I have knowledge of the facts, statements, and matters herein contained and the log of the above-described well as filed and that the same are true and correct. So help me God.

(Signature) Vicky Jacobs  
544 Petroleum Bldg, Wichita, Kan. (Address)

SUBSCRIBED AND SWORN to before me this 4th day of March, 19 53  
M. J. Schmidt Notary Public.

My commission expires 11/21/55

PLUGGING  
FILE SEC 35 T 11 R 19 34  
BOOK PAGE 82 LINE 21

35-53

## CONTRACTOR'S WELL LOG

OPERATOR C-G DRILLING CO. FARM NAME JENSEN #1  
 LOCATION NW NW SW Sec. 35-11-19W  
 POOL NAME Wildcat COUNTY Ellis STATE Kansas  
 COMMENCEMENT DATE February 19, 1953 COMPLETION DATE March 2, 1953

## LOG OF WELL

Elevation: 2174 R.B.

All measurements from the top of rotary bushing

FROM	TO	FORMATION	DEVIATION FROM VERTICAL	REMARKS:
0	169			
169	408	Shale		
408	1260	Shale-Sand-Shale		
1260	1518	Shale-Shells	0° - 1500'	
1518	1550	Anhydrite		
1550	1905	Shale-Sand		
1905	2160	Shale-Shells	0° - 2000'	
2160	2350	Shale-Lime		
2350	2463	Lime-Shale		
2463	2524	Lime-Shale	0° - 2500'	
2524	2624	Lime-Shale		
2624	2704	Lime-Shale		
2704	2825	Lime-Shale		
2825	2925	Lime-Shale		
2925	3048	Shale	0° - 3000'	
3048	3098	Lime-Shale		
3098	3218	Shale-Lime		
3218	3281	Lime		
3281	3326	Lime-Shale		
3326	3357	Lime-Shale		
3357	3410	Lime-Shale		
3410	3460	Lime-Shale		
3460	3499	Lime-Shale		
3499	3535	Lime	0° - 3500'	DST 3529'-3535'
3535	3589	Lime-Shale		
3589	3629	Lime-Shale		
3629	3665	Lime		
3665	3710	Lime-Shale		
3710	3746	Lime-Shale		DST 3739'-3746'

## CASING LEFT IN HOLE AFTER COMPLETION

Ran 173' (8 jts) of 8 5/8" OD Casing.

STATE OF KANSAS, COUNTY OF SEDGWICK ) ss.

The undersigned certifies that to the best of her knowledge and belief, the above facts are true and correct.

C-G DRILLING CO.

By *Vicky Jacobs*

Subscribed and sworn to before me this 4th day of March, 1953.

My commission expires: 11/21/55

*Marilyn Schmidt*

Notary Public

**PLUGGING**  
 FILE SEC 35 T 11 R 1934  
 BOOK PAGE 52 LINE 21