


Give All Information Completely  
Make Required Affidavit  
Mail or Deliver Report to:  
Conservation Division  
State Corporation Commission  
211 No. Broadway  
Wichita, Kansas

WELL PLUGGING RECORD

NORTH

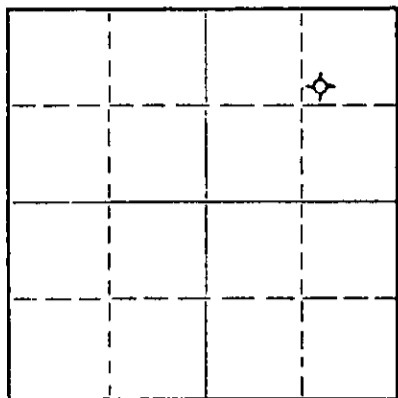

Locate well correctly on above Section Plat

Ellis County. Sec. 35 Twp. 11S Rge. 19W (E) (W)  
Location as "NE/CNW/SE/SW" or footage from lines SW NE NE  
Lease Owner J. F. Darby Oil Company Tulsa, Oklahoma  
Lease Name Vine "A" Well No. 4  
Office Address 1807 Philtower Building Tulsa, Oklahoma  
Character of Well (completed as Oil, Gas or Dry Hole) Dry Hole  
Date well completed October 17 1957  
Application for plugging filed October 17 1957  
Application for plugging approved October 17 1957  
Plugging commenced October 17 1957  
Plugging completed October 17 1957  
Reason for abandonment of well or producing formation Too low structurally

If a producing well is abandoned, date of last production 19  
Was permission obtained from the Conservation Division or its agents before plugging was commenced? Yes

Name of Conservation Agent who supervised plugging of this well Eldon Petty, Hays, Kansas  
Producing formation \_\_\_\_\_ Depth to top \_\_\_\_\_ Bottom \_\_\_\_\_ Total Depth of Well 3608 Feet  
Show depth and thickness of all water, oil and gas formations.

OIL, GAS OR WATER RECORDS

CASING RECORD

FORMATION	CONTENT	FROM	TO	SIZE	PUT IN	PULLED OUT
				8-5/8"	185.95'	none

Describe in detail the manner in which the well was plugged, indicating where the mud fluid was placed and the method or methods used in introducing it into the hole. If cement or other plugs were used, state the character of same and depth placed, from \_\_\_\_\_ feet to \_\_\_\_\_ feet for each plug set.

Filled hole with heavy mud to 600'. Set plug. Put in 20 sacks cement. Filled to 180'. Set plug. Put in 1/2 sack hulls and 20 sacks cement. Filled with heavy mud up to 40'. Set plug. Filled to top with 1/2 sack hulls and 10 sacks cement.

11-12-57

(If additional description is necessary, use BACK of this sheet)

Name of Plugging Contractor C-G Drilling Co.  
Address 107 Rule Building, Wichita, Kansas

STATE OF KANSAS, COUNTY OF SEDGWICK ss.  
G. F. Galloway (employee of owner) or (owner or operator) of the above-described well, being first duly sworn on oath, says: That I have knowledge of the facts, statements, and matters herein contained and the log of the above-described well as filed and that the same are true and correct. So help me God.

(Signature) G. F. Galloway  
G. F. Galloway 107 Rule Building  
(Address)

SUBSCRIBED AND SWORN TO before me this 23rd day of October, 1957

My commission expires May 20, 1959 Vicky Jacobs Notary Public.

PLUGGING  
SEC 35 T 11 S 19 W  
BOOK PAGE 55 LINE 32

**CONTRACTOR'S WELL LOG**

OPERATOR J. F. Galloway WELL NAME Vine "A" #4  
 LOCATION SE NE NE SEC. 35-11E-19N HIS NO. 2  
 COUNTY Ellis STATE Kansas  
 COMMENCEMENT DATE October 7, 1957 COMPLETION DATE October 17, 1957

**LOG OF WELL**

Elevation 21.6' rotary bushing.  
 All measurements taken from the top of rotary bushing.

FROM	TO	FORMATION	DEVIATION FROM VERTICAL	REMARKS
0	70	Shale		
70	185	Shale		
185	505	Shale-Shell		
505	910	Shale-Shell		
910	1035	Sand		
1035	1130	Sand		
1130	1450	Red Bed		
1450	1488	Anhydrite		
1488	1545	Shale-Shell		
1545	1870	Shale-Shell		
1870	2185	Shale-Shell		
2185	2225	Shale-Shell		
2225	2350	Shale-Lime		
2350	2430	Shale-Lime		
2430	2600	Shale-Lime	0° - 2500	
2600	2720	Shale-Lime		
2720	2800	Shale-Lime	0° - 2750	
2800	2955	Shale-Lime		
2955	3130	Shale-Lime	0° - 3000	
3130	3245	Shale-Lime		
3245	3280	Shale-Lime	0° - 3250	
3280	3325	Lime-Shale		
3325	3385	Lime-Shale		
3385	3425	Lime		
3425	3450	Lime		
3450	3514	Lime		
3514	3550	Lime		
3550	3597	Lime		
3597	3602	Lime		

DST 3555-3602'

**CASING LEFT IN HOLE AFTER COMPLETION**

Ran 185.96' (9 jts.) 8-5/8" OD Surface casing.

STATE OF KANSAS }  
 COUNTY OF SEDGWICK } ss.

The undersigned hereby certifies that to the best of his knowledge and belief, the above facts are true and correct.

C-G DRILLING CO.  
 By J. F. Galloway  
 J. F. Galloway

SUBSCRIBED AND SWORN TO BEFORE ME THIS 23rd day of October, 1957.

Victor Jacobs  
 Victor Jacobs, Notary Public

PLUGGING  
 FILE NO. 3511 R190  
 BOOK PAGE 55 LINE 22

My commission expires: May 20, 1958