

STATE OF KANSAS
STATE CORPORATION COMMISSION

15-109-20152-0000

WELL PLUGGING RECORD

Give All Information Completely
Make Required Affidavit
Mail or Deliver Report to
Conservation Division
State Corporation Comm.
245 North Water
Wichita, KS 67202

Logan County, Sec. 13 Twp. 11S Rge. 32 xR/W
Location as "NE/CNW\SW\ " or footage from lines

C NW NE
Lease Owner George R. Jones
Lease Name Pioneer Well No. #2

Office Address 125 N. Market - Suite 1310, Wichita, Ks. 67202
Character of Well (Completed as Oil, Gas or Dry Hole)

Dry Hole

Date Well completed 10-4-80 19
Application for plugging filed 10-4-80 19
Application for plugging approved 10-4-80 19
Plugging commenced 10-4-80 19
Plugging completed 10-4-80 19

Reason for abandonment of well or producing formation
Commercial quantities of oil not found


If a producing well is abandoned, date of last production 19

Was permission obtained from the Conservation Division or its agents before plugging was commenced? Yes

Name of Conservation Agent who supervised plugging of this well Gilbert Balthazor

Producing formation Depth to top Bottom Total Depth of Well 4610'

Show depth and thickness of all water, oil and gas formations.

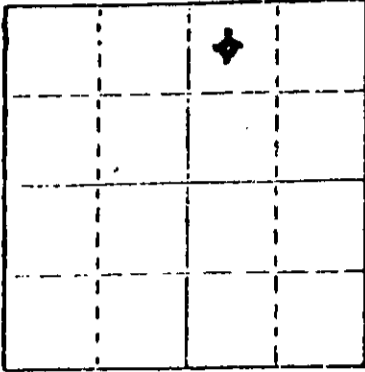

Locate well correctly on above Section Plot

OIL, GAS OR WATER RECORDS

CASING RECORD

FORMATION	CONTENT	FROM	TO	SIZE	PUT IN	PULLED OUT
				8 5/8"	287'	None

Describe in detail the manner in which the well was plugged, indicating where the mud fluid was placed and the method or methods used in introducing it into the hold. If cement or other plugs were used, state the character of same and depth placed, from feet to feet for each plug set.

Plug @ 260' w/20 sx.
Plug @ 150' w/70 sx.
Plug @ 40' w/10 sx.
Rat Hole 5 sx.

RECEIVED
STATE CORPORATION COMMISSION

OCT 16 1980

(If additional description is necessary, use BACK of sheet)

Name of Plugging Contractor Rains & Williamson Oil Co. Inc. Conservation Division Wichita, Kansas


STATE OF Kansas COUNTY OF Sedgwick, ss.
Wilson Rains, President of Rains & Williamson Oil Co. Inc. (employee of owner) or (owner or operator) of the above-described well, being first duly sworn on oath, says: That I have knowledge of the facts, statements, and matters herein contained and the log of the above-described well as filed and that the same are true and correct. So help me God.

(Signature) Wilson Rains
435 Page Court, 220 W. Douglas, Wichita, Ks. 67202 (Address)

SUBSCRIBED AND SWORN TO before me this 7 day of October, 19 80

My commission expires 10-4-83

Juanita M. Green
Juanita M. Green Notary Public.

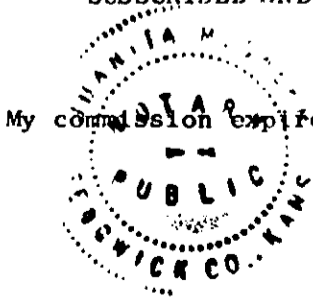

DRILLER'S LOG

15-109-20152-0000

COMPANY: George R. Jones

SEC. 13 T. 11S R. 32W

WELL NAME: Pioneer #2

LOC. C NW NE

RIG NO. #1

COUNTY: Logan

TOTAL DEPTH 4610'

ELEVATION

COMMENCED: 9-24-80

COMPLETED: 10-4-80

CONTRACTOR: Rains & Williamson Oil Co., Inc.

CASING RECORD:

SURFACE: 8 5/8" @ 287' w/250 sx. 60/40 poz., 2% gel, 3% cc.

PRODUCTION: D&A

LOG

(Figures Indicate Bottom of Formations)

Sand & Clay	220
Shale	2049
Shale & Lime	2630
Shale & Sand	3038
Sand & Shale	3466
Shale & Sand	3900
Shale & Lime	4090
Lime	4182
Shale & Lime	4223
Lime & Shale	4255
Shale & Lime	4307
Lime	4447
Lime & Shale	4610
<u>ROTARY TOTAL DEPTH</u>	<u>4610</u>

RECEIVED
STATE CORPORATION COMMISSION

OCT 16 1980

CONSERVATION DIVISION
Wichita, Kansas

STATE OF Kansas)
COUNTY OF Sedgwick) SS:

I, Wilson Rains, President of Rains & Williamson Oil Co., Inc.
upon oath state that the above and foregoing is a true and correct copy of the log of the
Pioneer #2 well.

Wilson Rains
Wilson Rains

Subscribed and sworn to before me this 7 day of October, 1980.

My Appointment Expires:
10-4-83

Juanita M. Green
Juanita M. Green

