


WELL PLUGGING RECORD

Give All Information Completely
Make Required Affidavit
Mail or Deliver Report to:
Conservation Division
State Corporation Commission
211 No. Broadway
Wichita, Kansas

NORTH

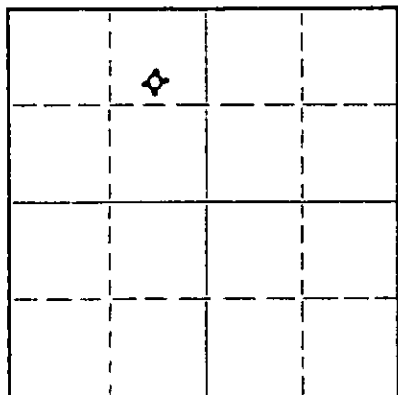

Locate well correctly on above
Section Plat

Location as "NE/CNW/SW" or footage from lines Ellis County. Sec. 35 Twp. 11 Rge. 19W (E) (W)
Location as "NE/CNW/SW" or footage from lines C S/2 NE NW
Lease Owner J. F. Darby Oil Company
Lease Name Vine "B" Well No. 2
Office Address 1807 Philtower Building, Tulsa, Oklahoma
Character of Well (completed as Oil, Gas or Dry Hole) Dry Hole
Date well completed August 22 1958
Application for plugging filed August 22 1958
Application for plugging approved August 22 1958
Plugging commenced August 22 1958
Plugging completed August 22 1958
Reason for abandonment of well or producing formation Too low structurally

If a producing well is abandoned, date of last production _____ 19____
Was permission obtained from the Conservation Division or its agents before plugging was commenced? Yes

Name of Conservation Agent who supervised plugging of this well Eldon Petty, Hays, Kansas
Producing formation _____ Depth to top _____ Bottom _____ Total Depth of Well 3702' Feet
Show depth and thickness of all water, oil and gas formations.

OIL, GAS OR WATER RECORDS

CASING RECORD

FORMATION	CONTENT	FROM	TO	SIZE	PUT IN	PULLED OUT
				8-5/8"	201.05'	none

Describe in detail the manner in which the well was plugged, indicating where the mud fluid was placed and the method or methods used in introducing it into the hole. If cement or other plugs were used, state the character of same and depth placed, from _____ feet to _____ feet for each plug set.

Filled hole with heavy mud to 550'. Set plug. Put in 20 sacks cement. Filled to 190'. Set plug. Put in 1/2 sack hulls and 15 sacks cement. Filled with heavy mud up to 40'. Set plug. Filled to top with 1/2 sack hulls and 10 sacks cement.

(If additional description is necessary, use BACK of this sheet)

Name of Plugging Contractor C-G Drilling Co.
Address 107 Rule Building, Wichita, Kansas

STATE OF KANSAS, COUNTY OF SEDGWICK, ss.
G. F. Galloway (employee of owner) or (owner or operator) of the above-described well, being first duly sworn on oath, says: That I have knowledge of the facts, statements, and matters herein contained and the log of the above-described well as filed and that the same are true and correct. So help me God.

(Signature) G. F. Galloway
G. F. Galloway
107 Rule Building
(Address)

SUBSCRIBED AND SWORN TO before me this 26th day of August, 1958

My commission expires May 20, 1959
Vicky Jacobs Notary Public.

PLUGGING
FILE SEC 35 T. 11 R. 19W
BOOK PAGE 126 LINE 38

CONTRACTOR'S WELL LOG

OPERATOR J. F. Darby Oil Company WELL NAME Vine "B" #2
 LOCATION C S/2 NE NW SEC. 35-11-19 RIG NO. 2
 COUNTY Ellis STATE Kansas
 COMMENCEMENT DATE August 12, 1958 COMPLETION DATE August 22, 1958

LOG OF WELL

Elevation 2128' kelly bushing.
 All measurements taken from the top of kelly bushing.

FROM	TO	FORMATION	DEVIATION FROM VERTICAL	REMARKS:
0	201	Shale-Sand		
201	340	Shale-Sand		
340	710	Shale-Sand		
710	1150	Shale-Sand		
1150	1340	Red Bed		
1340	1485	Red Bed		
1485	1520	Anhydrite		
1520	1620	Shale-Shell		
1620	1646	Shale-Shell		
1646	1970	Shale-Shell		
1970	2030	Shale-Shell		
2030	2105	Shale-Lime		
2105	2250	Shale-Lime		
2250	2415	Shale-Lime		
2415	2485	Shale-Lime		
2485	2660	Shale-Lime	0° - 2500	
2660	2795	Shale-Lime	0° - 2750	
2795	2935	Shale-Lime		
2935	3027	Shale-Lime	0° - 3000	
3027	3175	Shale-Lime		
3175	3274	Shale-Lime	0° - 3250	
3274	3331	Lime-Shale		
3331	3370	Lime-Shale		
3370	3425	Shale-Lime		
3425	3474	Lime		
3474	3518	Lime		
3518	3548	Lime		
3548	3596	Lime		
3596	3655	Lime		
3655	3685	Lime		
3685	3691	Lime		DST 3688-3691'
3691	3694	Lime		DST 3689-3694'
3694	3697	Arbuckle		DST 3691-3697'
3697	3702	Arbuckle		

CASING LEFT IN HOLE AFTER COMPLETION

Ran 201.05' (10 jts.) 8-5/8" OD Surface Casing.

STATE OF KANSAS }
 COUNTY OF SEDGWICK } SS.

The undersigned hereby certifies that to the best of his knowledge and belief, the above facts are true and correct.

PLUGGING
 FILE SEC 35 T 11 R 19W
 BOOK PAGE 126 LINE 38

C-G DRILLING CO.

By G. F. Galloway
 G. F. Galloway

SUBSCRIBED AND SWORN TO BEFORE ME THIS 26th day of August, 1958.

My commission expires: May 20, 1959
Vicky Jacobs
 Vicky Jacobs, Notary Public