


STATE OF KANSAS  
STATE CORPORATION COMMISSION

Form CP-4

Give All Information Completely  
Make Required Affidavit  
Mail or Deliver Report to:  
Conservation Division  
State Corporation Commission  
P. O. Box 17027  
Wichita, Kansas 67217  
NORTH

WELL PLUGGING RECORD

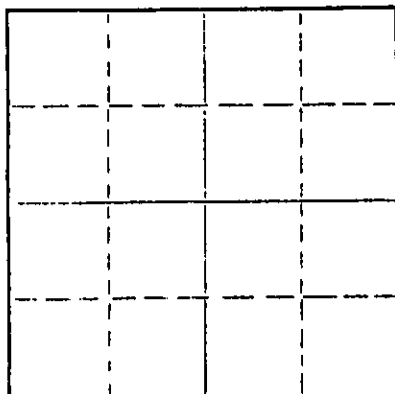

Locate well correctly on above  
Section Plat

Logan County. Sec. 26 Twp. 11 Rge. (E) 33W (W)  
Location as "NE/CNW/SE/SW" or footage from lines C NW SW  
Lease Owner Donald C. Slawson  
Lease Name Bertrand 'G' Well No. 3  
Office Address 200 Douglas Building Wichita, Kansas 67202  
Character of Well (completed as Oil, Gas or Dry Hole) Dry Hole  
Date well completed Apr. 8, 1979  
Application for plugging filed Apr. 8, 1979  
Application for plugging approved Apr. 8, 1979  
Plugging commenced Apr. 8, 1979  
Plugging completed Apr. 8, 1979  
Reason for abandonment of well or producing formation Dry Hole  
If a producing well is abandoned, date of last production 19  
Was permission obtained from the Conservation Division or its agents before plugging was commenced? Yes

Name of Conservation Agent who supervised plugging of this well Gilbert Balthazor  
Producing formation \_\_\_\_\_ Depth to top \_\_\_\_\_ Bottom \_\_\_\_\_ Total Depth of Well 4756' Feet  
Show depth and thickness of all water, oil and gas formations.

OIL, GAS OR WATER RECORDS

CASING RECORD

FORMATION	CONTENT	FROM	TO	SIZE	PUT IN	PULLED OUT
	347.19	surface	344'	8 5/8"		

Describe in detail the manner in which the well was plugged, indicating where the mud fluid was placed and the method or methods used in introducing it into the hole. If cement or other plugs were used, state the character of same and depth placed, from \_\_\_\_\_ feet to \_\_\_\_\_ feet for each plug set.

1st plug @ 1400' w/70 sx  
2nd plug @ 300' w/ 20 sx  
Top plug @ 40' w/10 sx  
5 sx in rat hole

RECEIVED  
STATE CORPORATION COMMISSION  
JUL 16 1979  
CONSERVATION DIVISION  
WICHITA, KANSAS

(If additional description is necessary, use BACK of this sheet)  
Name of Plugging Contractor SLAWSON DRILLING CO., INC.  
Address 200 Douglas Building Wichita, Kansas 67202

STATE OF KANSAS, COUNTY OF SEDGWICK, ss.  
R. J. THATCHER (employee of owner) or (owner or operator) of the above-described well, being first duly sworn on oath, says: That I have knowledge of the facts, statements, and matters herein contained and the log of the above-described well as filed and that the same are true and correct. So help me God.

(Signature) R. J. Thatcher  
R. J. THATCHER 200 Douglas Bldg., Wichita, KS.  
(Address)

SUBSCRIBED AND SWORN TO before me this 15th day of May, 1979  
Sherry L. Milford  
Sherry L. Milford Notary Public.

My commission expires 6/12/82



WELL LOG

OPERATOR: Donald C. Slawson  
 200 Douglas Building  
 Wichita, Kansas 67202

LEASE: #3 Bertrand 'G'  
 C NW SW of Sec. 26-11-33W  
 Logan County, Kansas

CONTRACTOR: Slawson Drilling Co., Inc.  
 200 Douglas Building  
 Wichita, Kansas 67202

COMMENCED: March 28, 1979

COMPLETED: April 8, 1979

CASING: Surface - 8 5/8" @ 344' w/250 sx 60/40 poz

0 - 348 Surface  
 348 - 1364 Shale and sand  
 1364 - 2278 Shale and shells  
 2278 - 2841 Shale and sand  
 2841 - 4073 Lime and shale  
 4073 - 4450 Lime  
 4450 - 4563 Lime and shale  
 4563 - 4756 Lime  
 4756 RTD

RECEIVED  
 STATE CORPORATION COMMISSION

JUL 16 1979

CONSERVATION DIVISION  
 Wichita, Kansas

STATE OF KANSAS )  
 ) SS.  
 COUNTY OF SEDGWICK )

I, R.J. THATCHER, of the Slawson Drilling Company, Inc. upon oath state that the above and foregoing is a true and correct copy of the log of the #3 Bertrand 'G' test.

*R.J. Thatcher*  
 R.J. THATCHER

Subscribed and sworn to before me this 15th day of May, 1979.

*Sherry L. Milford*  
 SHERRY L. MILFORD, Notary Public

My Commission Expires: 6/12/82

