


STATE OF KANSAS
STATE CORPORATION COMMISSION

Give All Information Completely
Make Required Affidavit
Mail or Deliver Report to:
Conservation Division
State Corporation Commission
P. O. Box 17027
Wichita, Kansas 67217
NORTH

WELL PLUGGING RECORD

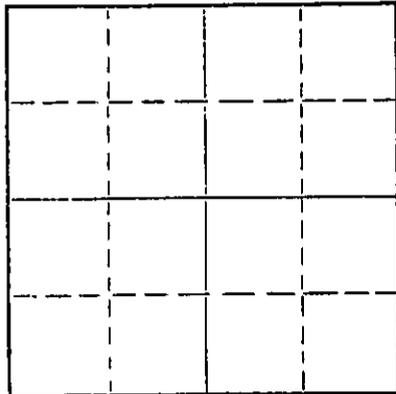

Locate well correctly on above
Section Plat

Logan County, Sec. 15 Twp. 11 Rge. 33W (E) (W)
Location as "NE/CNW/SW" or footage from lines. NW SW NE
Lease Owner Donald C. Slawson
Lease Name Pinkston "A" Well No. 1
Office Address 408 120 Bldg. Wichita, Ks. 67202
Character of Well (completed as Oil, Gas or Dry Hole) Dry Hole
Date well completed July 18 1975
Application for plugging filed July 18 1975
Application for plugging approved July 18 1975
Plugging commenced July 18 1975
Plugging completed July 18 1975
Reason for abandonment of well or producing formation Dry Hole

If a producing well is abandoned, date of last production 19
Was permission obtained from the Conservation Division or its agents before plugging was commenced? Yes

Name of Conservation Agent who supervised plugging of this well Gilbert Balthazor Route 1 Palco, Ks.
Producing formation Depth to top Bottom Total Depth of Well 4682 Feet
Show depth and thickness of all water, oil and gas formations.

OIL, GAS OR WATER RECORDS

CASING RECORD

FORMATION	CONTENT	FROM	TO	SIZE	PUT IN	PULLED OUT
8 5/8"	190 feet				250 feet	

Describe in detail the manner in which the well was plugged, indicating where the mud fluid was placed and the method or methods used in introducing it into the hole. If cement or other plugs were used, state the character of same and depth placed, from feet to feet for each plug set.

1st plug @ 1500' w/70 sx
2nd plug @ 250' w/20 sx
3rd plug @ 40' w/10 sx

8-4-75

(If additional description is necessary, use BACK of this sheet)
Name of Plugging Contractor Slawson Drilling Company, Inc.
Address 408 120 Bldg. Wichita, Ks. 67202

STATE OF Kansas, COUNTY OF Sedgwick
James C. Resmberg (employee of owner) or (owner or operator) of the above-described well, being first duly sworn on oath, says: That I have knowledge of the facts, statements, and matters herein contained and the log of the above-described well as filed and that the same are true and correct. So help me God.

(Signature) James C. Resmberg
James C. Resmberg

SUBSCRIBED AND SWORN TO before me this 30th day of July (Address)

My commission expires
DOLORES B. COADY
STATE NOTARY PUBLIC
SEDGWICK COUNTY, KANSAS
Comm. Expires Mar. 7, 1976

(Signature) Dolores B. Coady
Dolores B. Coady Notary Public.

WELL LOG

OPERATOR: Donald C. Slawson
 408 120 Bldg.
 Wichita, Kansas 67202

LEASE: #1 Pinkston "A"
 NW SW NE of Sec. 15-11-33W
 Logan County, Kansas

CONTRACTOR: Slawson Drilling Company, Inc.

COMMENCED: July 7, 1975

COMPLETED: July 18, 1975

CASING: Set 8 5/8" @ 250' w/200 sx

TOTAL DEPTH: 4682 feet

0 - 255 Surface Hole
 255 - 2641 Shale & Shells
 2641 - 2668 Anhydrite
 2668 - 2903 Shale & Shells
 2903 - 3168 Shale
 3168 - 4123 Shale & Lime
 4123 - 4682 Lime
 4682 RTD

Sum
 1975

STATE OF KANSAS)
) SS.
 COUNTY OF SEDGWICK)

I, JAMES C. REMSBERG, of the Slawson Drilling Company, Inc. upon oath state that the above and foregoing is a true and correct copy of the log of the #1 Pinkston "A" well.

James C. Remsberg

 JAMES C. REMSBERG

Subscribed and sworn to before me this 30th day of July, 1975

Dolores B. Coady

 Dolores B. Coady, Notary Public

My Commission Expires:

DOLORES B. COADY
 STATE NOTARY PUBLIC
 SEDGWICK COUNTY, KANSAS
 Comm. Expires Mar. 7, 1978