


STATE OF KANSAS
STATE CORPORATION COMMISSION

Give All Information Completely
Make Required Affidavit
Mail or Deliver Report to:
Conservation Division
State Corporation Commission
P. O. Box 17027
Wichita, Kansas 67217
NORTH

WELL PLUGGING RECORD

Logan County, Sec. 13 Twp. 11S Rge. 34W (E) (W)

Location as "NE/CNW&SW" or footage from lines C NE
Lease Owner DONALD C. SLAWSON
Lease Name Wasse Miller 'H' Well No. 1
Office Address 200 Douglas Building Wichita, Kansas 67202
Character of Well (completed as Oil, Gas or Dry Hole) Dry Hole
Date well completed December 23, 19 81
Application for plugging filed December 23, 19 81
Application for plugging approved December 23, 19 81
Plugging commenced December 22, 19 81
Plugging completed December 23, 19 81
Reason for abandonment of well or producing formation Dry Hole

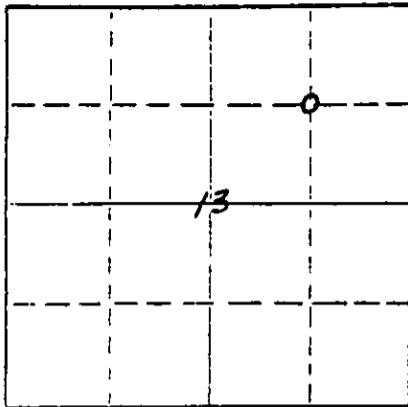

Locate well correctly on above Section Plat

If a producing well is abandoned, date of last production 19
Was permission obtained from the Conservation Division or its agents before plugging was commenced? Yes

Name of Conservation Agent who supervised plugging of this well Carl Goodrow
Producing formation Depth to top Bottom Total Depth of Well 4830 Feet
Show depth and thickness of all water, oil and gas formations.

OIL, GAS OR WATER RECORDS

CASING RECORD

FORMATION	CONTENT	FROM	TO	SIZE	PUT IN	PULLED OUT
		surface	570'	8 5/8"		


Describe in detail the manner in which the well was plugged, indicating where the mud fluid was placed and the method or methods used in introducing it into the hole. If cement or other plugs were used, state the character of same and depth placed, from feet to feet for each plug set.

1st plug @ 1440' w/70 sx
2nd plug @ 550' w/40 sx
Top plug @ 40' w/10 sx
10 sx in Rat Hole

Name of Plugging Contractor Sun Oil Well Cementing, Inc.
Address Box 169 Great Bend, Kansas 67530

STATE OF KANSAS COUNTY OF SEDGWICK
William R. Horigan (employee of owner) or (owner or operator) of the above described well,

being first duly sworn on oath, says: That I have knowledge of the facts, statements, and matters herein contained and the log of the above described well as filed and that the same are true and correct. So help me God.

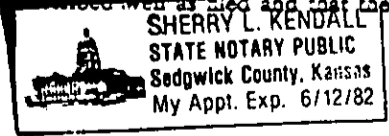

(Signature) William R. Horigan
William R. Horigan
200 Douglas Bldg. (Address) Wichita, Kansas 67202

RECEIVED
FEB 24 1982
CONSERVATION DIVISION
WICHITA, KANSAS

Subscribed and sworn to before me this 16th day of February 19 82

My commission expires 06/12/82

Sherry L. Kendall
Notary Public
CONSERVATION DIVISION
Wichita, Kansas