


STATE OF KANSAS
STATE CORPORATION COMMISSION

WELL PLUGGING RECORD

Give All Information Completely
Make Required Affidavit
Mail or Deliver Report to
Conservation Division
State Corporation Comm.
245 North Water
Wichita, KS 67202

Logan County, Sec. 15 Twp. 11S Rge. 33WE/W
Location as "NE/CNW $\frac{1}{4}$ SW $\frac{1}{4}$ " or footage from lines
C SE SE NE
Lease Owner Abercrombie Drilling, Inc.
Lease Name Pinkston Well No. 1
Office Address 801 Union Center, Wichita, Kansas
Character of Well (Completed as Oil, Gas or Dry Hole) Dry Hole

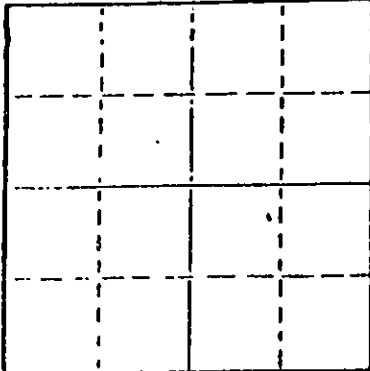

Locate well correctly on above
Section Plot

Date Well completed Jan. 12 1979
Application for plugging filed (verbally) Jan. 12 1979
Application for plugging approved (verbally) Jan. 12 1979
Plugging commenced Jan. 12 1979
Plugging completed Jan. 12 1979

Reason for abandonment of well or producing formation
No commercial quantity of oil or gas encountered.
If a producing well is abandoned, date of last production 19

Was permission obtained from the Conservation Division or
its agents before plugging was commenced? Yes

Name of Conservation Agent who supervised plugging of this well Gilbert Balthazor
Producing formation Depth to top Bottom Total Depth of Well 4670'
Show depth and thickness of all water, oil and gas formations.


OIL, GAS OR WATER RECORDS

CASING RECORD

FORMATION	CONTENT	FROM	TO	SIZE	PUT IN	PULLED OUT

Describe in detail the manner in which the well was plugged, indicating where the mud fluid was placed and the method or methods used in introducing it into the hold. If cement or other plugs were used, state the character of same and depth placed, from feet to feet for each plug set.

T.D. 4670'
Set 1st plug at 1400' with 70 sacks
2nd plug at 240' with 20 sacks
3rd plug at 40' solid bridge with 10 sacks
rathole with 5 sacks.
Cemented with 50/50 posmix, 6% gel.
Plug was down at 3:00 a.m., 1-12-79.

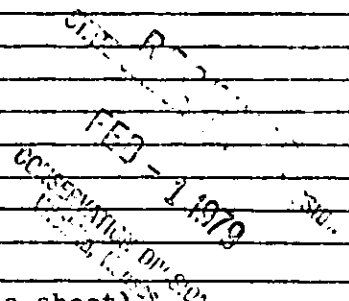

(If additional description is necessary, use BACK of this sheet)

Name of Plugging Contractor Abercrombie Drilling, Inc.

STATE OF Kansas COUNTY OF Sedgwick, ss.
Jack L. Partridge, Asst. Sec.-Treas. (employee of owner) or (owner or operator)
of the above-described well, being first duly sworn on oath, says: That I have knowledge of the facts, statements, and matters herein contained and the log of the above-described well as filed and that the same are true and correct. So help me God.



(Signature) Jack L. Partridge
801 Union Center, Wichita, Kansas
(Address)

SUBSCRIBED AND SWORN TO before me this 30th day of January, 1979

Sherrie L. Brooks
Notary Public.

My commission expires 8-21-82

IMPORTANT
 Kans. Geo. Survey request
 samples on this well.

KANSAS DRILLERS LOG

S. 15 T. 11 R. 33 ^N/_W

API No. 15 — 109 — 20,125-0000
 County Number

Loc. SE SE NE

County Logan

Operator
Abercrombie Drilling, Inc.

Address
801 Union Center Wichita, Kansas 67202


Well No. # 1 Lease Name Pinkston

Footage Location
 feet from (N) (S) line feet from (E) (W) line

Principal Contractor Abercrombie Drilling, Inc Geologist Ralph White

Spud Date January 2, 1979 Total Depth 4670' P.B.T.D.

Date Completed January 12, 1979 Oil Purchaser

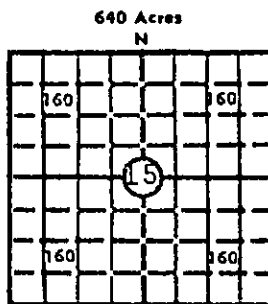

Locate well correctly
3139'

Elev.: Gr. 3142' KB 3144'

CASING RECORD

Report of all strings set— surface, intermediate, production, etc.

Purpose of string	Size hole drilled	Size casing set (in O.D.)	Weight lbs/ft.	Setting depth	Type cement	Sacks	Type and percent additives
Surface	12 $\frac{1}{4}$ "	8-5/8"		265'	60/40 posmix	200	3% Ca.Cl.

LINER RECORD

PERFORATION RECORD

Top, ft.	Bottom, ft.	Sacks cement	Shots per ft.	Size & type	Depth interval

TUBING RECORD

Size	Setting depth	Packer set at

ACID, FRACTURE, SHOT, CEMENT SQUEEZE RECORD

Amount and kind of material used	Depth interval treated

INITIAL PRODUCTION

Date of first production		Producing method (flowing, pumping, gas lift, etc.)			
RATE OF PRODUCTION PER 24 HOURS	Oil	Gas	Water	Gas-oil ratio	CFPB
	bbls.	MCF	bbls.		
Disposition of gas (vented, used on lease or sold)			Producing interval (s)		

RECEIVED
 FEB - 1 1979
 CONSERVATION DIVISION
 STATE GEOLOGICAL SURVEY OF KANSAS

INSTRUCTIONS: As provided in KCC Rule 82-2-125, within 90 days after completion of a well, one completed copy of this Drillers Log shall be transmitted to the State Geological Survey of Kansas, 4150 Monroe Street, Wichita, Kansas 67209. Copies of this form are available from the Conservation Division, State Corporation Commission, 3830 So. Meridian (P.O. Box 17027), Wichita, Kansas 66217. Phone AC 316-522-2206. If confidential custody is desired, please note Rule 82-2-125. Drillers Logs will be on an open file in the Oil and Gas Division, State Geological Survey of Kansas, Lawrence, Kansas 66044.

Operator
Abercrombie Drilling, Inc.

DESIGNATE TYPE OF COMP.: OIL, GAS,
DRY HOLE, SWDW, ETC.:
Dry Hole

Well No. 1 Lease Name Pinkston

S 15 T 11SR 33W


WELL LOG

Show all important zones of porosity and contents thereof; cored intervals, and all drill-stem tests, including depth interval tested, cushion used, time tool open, flowing and shut-in pressures, and recoveries.

SHOW GEOLOGICAL MARKERS, LOGS RUN, OR OTHER DESCRIPTIVE INFORMATION.

FORMATION DESCRIPTION, CONTENTS, ETC.	TOP	BOTTOM	NAME	DEPTH
Sand and clay	0	62	<u>SAMPLE TOPS:</u>	
Sand and shale	62	266		
Shale	266	750	Anhydrite	2632' (+ 512)
Shale and sand	750	1908	Heebner	4056' (- 912)
Shale	1908	2632	Toronto	4083' (- 939)
Anhydrite	2632	2676	Lansing	4101' (- 957)
Shale	2676	2918	B/KC	4386' (-1242)
Shale and lime	2918	3685	Pawnee	4519' (-1375)
Lime and shale	3685	3974	U. Cherokee	4577' (-1433)
Lime	3974	4670	L. Cherokee	4608' (-1464)
Rotary Total Depth		4670	Johnson Zone	4654' (-1570)
DST #1 (4235-4265') 30", 30", 30", 30"				
Rec. 15' mud with few spts oil IFP 30-30, IBHP 142, FFP 40-40, FBHP 183. Temp. 112°				
DST #2 (4290-4345') 30", 45", 60" 45"				
Rec. 534' mdy wtr. IFP 51-122, IBHP 1232, FFP 163-255 FBHP 1192. Temp. 114°				
DST #3 (4601-4670') 30", 30", 30", 30"				
Rec. 30' osm IFP 40-40, IBHP 408, FFP 51-51, FBHP 102. Temp. 117°				

USE ADDITIONAL SHEETS, IF NECESSARY, TO COMPLETE WELL RECORD.

Date Received	
	Signature
	Jack L. Partridge, Asst. Sec-Treas.
	Title
	January 30, 1979
	Date