


Give All Information Completely
Make Required Affidavit
Mail or Deliver Report to:
Conservation Division
State Corporation Commission
P. O. Box 17027
Wichita, Kansas 67217
NORTH

WELL PLUGGING RECORD

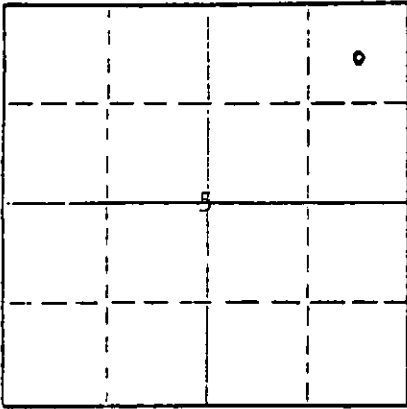

Locate well correctly on above
Section Plat

Ness County, Sec. 5 Twp. 18S Rge. (E) 24W (W)
Location as "NE/CNW/SW" or footage from lines C NE NE
Lease Owner DONALD C. SLAWSON
Lease Name Wirtz 'C' Well No. 1
Office Address 200 Douglas Building Wichita, Kansas 67202
Character of Well (completed as Oil, Gas or Dry Hole) Dry Hole
Date well completed January 29, 19 82
Application for plugging filed January 29, 19 82
Application for plugging approved January 29, 19 82
Plugging commenced January 29, 19 82
Plugging completed January 29, 19 82
Reason for abandonment of well or producing formation Dry Hole

If a producing well is abandoned, date of last production 19
Was permission obtained from the Conservation Division or its agents before plugging was commenced? Yes

Name of Conservation Agent who supervised plugging of this well Steve Durrant
Producing formation Depth to top Bottom Total Depth of Well 4430 Feet
Show depth and thickness of all water, oil and gas formations.

OIL, GAS OR WATER RECORDS

CASING RECORD

FORMATION	CONTENT	FROM	TO	SIZE	PUT IN	PULLED OUT
		surface	416'	8 5/8"		

Describe in detail the manner in which the well was plugged, indicating where the mud fluid was placed and the method or methods used in introducing it into the hole. If cement or other plugs were used, state the character of same and depth placed, from feet to feet for each plug set.

1st plug @ 900' w/70 sx
2nd plug @ 390' w/40 sx
Solid Bridge @ 40' w/10 sx
5 sx in Rat Hole

RECEIVED
STATE CORPORATION COMMISSION


RECEIVED
STATE CORPORATION COMMISSION
APR 21 1982

APR 21 1982
04-21-82
CONSERVATION DIVISION
Wichita, Kansas

Name of Plugging Contractor Allied Cementing Co., Inc. (If additional description is necessary, use BACK of this sheet)
Address Box 31 Russell, Kansas 67665

STATE OF KANSAS COUNTY OF SEDGWICK ss.
William R. Horigan (employee of owner) or (owner or operator) of the above-described

well, being first duly sworn on oath, says: That I have knowledge of the facts, statements, and matters herein contained and the log of the above-described well as filed and that the same are true and correct. So help me God.

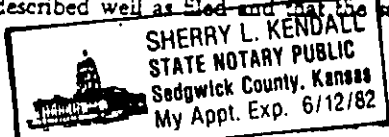

(Signature) William R. Horigan
William R. Horigan 200 Douglas Building Wichita, Kansas 67202
(Address)

Subscribed and Sworn to before me this 12th day of April, 19 82

My commission expires 06/12/82
Sherry L. Kendall Notary Public.