

15-135-00009-0000


STATE OF KANSAS  
STATE CORPORATION COMMISSION

WELL PLUGGING RECORD

Give All Information Completely  
Make Required Affidavit  
Mail or Deliver Report to:  
Conservation Division  
State Corporation Commission  
800 Bittling Building  
Wichita, Kansas

Ness County. Sec. 5 Twp. 18S Rge. 24W (E) (W)  
Location as "NE/CNW/SW" or footage from lines SW SW NE  
Lease Owner Leben Drilling Co.  
Lease Name Wirtz Well No. 1  
Office Address 505 Orpheum Bldg, Wichita, Kansas  
Character of Well (completed as Oil, Gas or Dry Hole) Dry Hole  
Date well completed October 19 19 55  
Application for plugging filed " 19 "  
Application for plugging approved " 19 "  
Plugging commenced " 19 "  
Plugging completed " 19 "  
Reason for abandonment of well or producing formation Dry Hole

NORTH

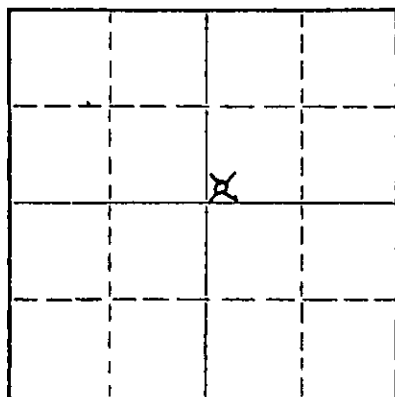

Locate well correctly on above  
Section Plat

If a producing well is abandoned, date of last production \_\_\_\_\_ 19\_\_\_\_  
Was permission obtained from the Conservation Division or its agents before plugging was com-  
menced? Yes

Name of Conservation Agent who supervised plugging of this well W. H. Horner  
Producing formation \_\_\_\_\_ Depth to top \_\_\_\_\_ Bottom \_\_\_\_\_ Total Depth of Well 4726 Feet  
Show depth and thickness of all water, oil and gas formations.

OIL, GAS OR WATER RECORDS

CASING RECORD

FORMATION	CONTENT	FROM	TO	SIZE	PUT IN	PULLED OUT
				8 5/8"	190	

Describe in detail the manner in which the well was plugged, indicating where the mud fluid was placed and the method or methods used in introducing it into the hole. If cement or other plugs were used, state the character of same and depth placed, from \_\_\_\_\_ feet to \_\_\_\_\_ feet for each plug set.

Bottom Plug @ 180 feet w/15 sacks  
cement, 1/2 sk hulls.

10-28-55

(If additional description is necessary, use BACK of this sheet)

Name of Plugging Contractor Leben Drilling Company  
Address 505 Orpheum Bldg, Wichita, Kansas

STATE OF KANSAS, COUNTY OF SEDGWICK, ss.  
Norma D. Sisson (employee of owner) or (~~owner or operator~~) of the above-described well, being first duly sworn on oath, says: That I have knowledge of the facts, statements, and matters herein contained and the log of the above-described well as filed and that the same are true and correct. So help me God

(Signature) Norma D Sisson  
Wichita, Kansas  
(Address)

SUBSCRIBED AND SWORN TO before me this 27th day of October, 19 55  
Norma D Sisson  
Norma D. Sisson Notary Public.

My commission expires April 20, 1959

PLUGGING  
FILE NO. S.T. 18 R 24 W  
BOOK PAGE 14 LINE 39

CONTRACTOR'S WELL LOG

COMPANY: Leben Drilling Company and Bankoff Oil Company  
 CONTRACTOR: Leben Drilling Company  
 FARM: Wirtz #1  
 LOCATION: SW SW NE Sec. 5-18S-24W, Ness County, Kansas  
 COMMENCED: October 4, 1955  
 COMPLETED: October 19, 1955

0	40	Surface soil
40	200	Blue shale
200	360	Shale, shells
360	500	Shale, sand
500	580	Shale, shells
580	690	Sand
690	1005	Red Shale
1005	1020	Lime
1020	1640	Shale, sand
1640	1680	Anhydrite
1680	2276	Shale, shells
2276	2425	Lime, shale
2425	2560	Shale, lime
2560	2835	Lime
2835	3180	Shale, lime
3180	3335	Shale, shells
3335	3580	Lime, shale
3580	3645	Lime
3645	3705	Lime, shale
3705	4030	Lime
4030	4305	Lime, shale
4305	4345	Lime, shale
4345	4544	Lime
4544	4572	Lime, chert
4572	4726	Lime
	<u>4726</u>	<u>Rotary Total Depth - D &amp; A</u>

Set 8 5/8" surface casing at 190 feet.

I, Norma D. Sisson, do hereby certify that the above and foregoing is a true and correct copy of the log of the Wirtz #1, SW SW NE Sec. 5-18S-24W, Ness County, Kansas, as reflected by the files of the Leben Drilling Company.

LEBEN DRILLING COMPANY  
 BY: Norma D Sisson

STATE OF KANSAS ) SS  
 COUNTY OF SEDGWICK )

Subscribed and sworn to before me, a Notary Public, in and for Sedgwick County, Kansas, this 27th day of October, 1955.

Norma D Sisson  
 Notary Public

My commission expires April 20, 1959

RECEIVED  
 STATE OF KANSAS  
 OCT 22 1955  
 RECORDS DIVISION  
 KANSAS

PLUGGING  
 FILE NO. 5 T 18 24W  
 BOOK PAGE 11 LINE 31