

15-135-21570-0000

STATE OF KANSAS
STATE CORPORATION COMMISSION


Form CP-4

Give All Information Completely
Make Required Affidavit
Mail or Deliver Report to:
Conservation Division
State Corporation Commission
P. O. Box 17027
Wichita, Kansas 67217
NORTH

WELL PLUGGING RECORD

Ness County, Sec. 5 Twp. 18 Rge. 24W (E) (W)

Location as "NE/CNWKSWK" or footage from lines C NW NW
Lease Owner DONALD C. SLAWSON
Lease Name Wirtz 'B' Well No. 1
Office Address 200 Douglas Building Wichita, Kansas 67202
Character of Well (completed as Oil, Gas or Dry Hole) Dry Hole
Date well completed January 14, 19 79
Application for plugging filed January 14, 19 79
Application for plugging approved January 14, 19 79
Plugging commenced January 14, 19 79
Plugging completed January 14, 19 79
Reason for abandonment of well or producing formation Dry Hole

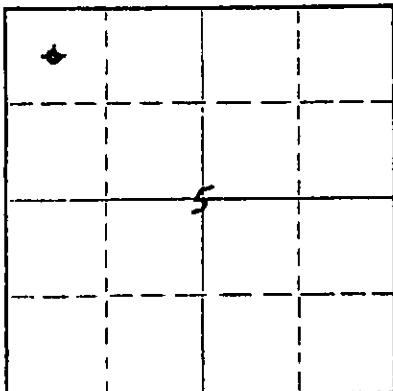

Locate well correctly on above Section Plat

If a producing well is abandoned, date of last production 19
Was permission obtained from the Conservation Division or its agents before plugging was commenced? Yes

Name of Conservation Agent who supervised plugging of this well Leo F. Massey
Producing formation _____ Depth to top _____ Bottom _____ Total Depth of Well 4460 Feet
Show depth and thickness of all water, oil and gas formations.

OIL, GAS OR WATER RECORDS

CASING RECORD

FORMATION	CONTENT	FROM	TO	SIZE	PUT IN	PULLED OUT
	385.57'	surface	393'	8 5/8"		

Describe in detail the manner in which the well was plugged, indicating where the mud fluid was placed and the method or methods used in introducing it into the hole. If cement or other plugs were used, state the character of same and depth placed, from _____ feet to _____ feet for each plug set.

1st plug @ 550' w/70 sx
2nd plug @ 300' w/20 sx
Solid Bridge @ 40' w/10 sx
2 sx in Rat Hole

RECEIVED
STATE CORPORATION COMMISSION
MAR 12 1979
CONSERVATION DIVISION
Wichita, Kansas

(If additional description is necessary, use BACK of this sheet)
Name of Plugging Contractor Slawson Drilling Company, Inc.
Address 200 Douglas Building Wichita, Kansas 67202

STATE OF KANSAS, COUNTY OF SEDGWICK, ss.
R.J. Thatcher, (employee of owner) or (owner or operator) of the above-described well, being first duly sworn on oath, says: That I have knowledge of the facts, statements, and matters herein contained and the log of the above-described well as filed and that the same are true and correct. So help me God.

(Signature) R.J. THATCHER 200 Douglas Bldg. Wichita, KS

SUBSCRIBED AND SWORN TO before me this 9th day of March, 19 79

Sherry L. Milford
Sherry L. Milford Notary Public.

My commission expires 6/12/82



15-135-21570-0000

WELL LOG

OPERATOR: DONALD C. SLAWSON
 200 Douglas Building
 Wichita, Kansas 67202

LEASE: #1 Wirtz 'B'
 C NW NW Sec. 5-18-24W
 Ness County, Kansas

CONTRACTOR: Slawson Drilling Co., Inc.
 200 Douglas Building
 Wichita, Kansas 67202

COMMENCED: January 5, 1979

COMPLETED: January 14, 1979

CASING: Surface - 8 5/8" @ 393' w/235 sx 60/40 poz

0 - 398 Yellow clay, shale
 398 - 1495 Shale and sand
 1495 - 1655 Red Bed (shale)
 1655 - 1693 Anhydrite
 1693 - 2396 Shale
 2396 - 3970 Lime and shale
 3970 - 4372 Lime
 4372 - 4460 Mississippi
 4460 RTD

RECEIVED
 STATE CORPORATION COMMISSION
 MAR 12 1979
 CONSERVATION DIVISION
 Wichita, Kansas

STATE OF KANSAS)
) SS.
 COUNTY OF SEDGWICK)

I, R. J. THATCHER, of the Slawson Drilling Co., Inc. upon oath state that the above and foregoing is a true and correct copy of the log of the #1 Wirtz 'B' test.

R. J. Thatcher
 R. J. THATCHER, Engineer

Subscribed and sworn to before me this 9th day of March, 1979.

Sherry L. Milford
 SHERRY L. MILFORD, Notary Public

My Commission Expires: 6/12/82

