
STATE OF KANSAS
STATE CORPORATION COMMISSION

Give All Information Completely
Make Required Affidavit
Mail or Deliver Report to:
Conservation Division
State Corporation Commission
211 No. Broadway
Wichita, Kansas

15-135-00073-0000

WELL PLUGGING RECORD

NORTH

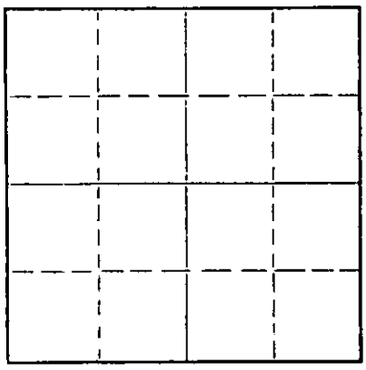

Locate well correctly on above Section Plat

Ness County. Sec. 11 Twp. 18S Rge. 24W (E) W (W)

Location as "NE/CNW¼SW¼" or footage from lines C SE SE

Lease Owner Rex & Morris, Etal

Lease Name Floyd Well No. 1

Office Address Box 334, El Dorado, Kansas

Character of Well (completed as Oil, Gas or Dry Hole) Dry Hole

Date well completed April 23 1958

Application for plugging filed " 19 "

Application for plugging approved " 19 "

Plugging commenced " 19 "

Plugging completed " 19 "

Reason for abandonment of well or producing formation Dry Hole

If a producing well is abandoned, date of last production 19

Was permission obtained from the Conservation Division or its agents before plugging was commenced? Yes

Name of Conservation Agent who supervised plugging of this well Gilbert Leiker, Victoria, Kansas

Producing formation Depth to top Bottom Total Depth of Well 4470 Feet

Show depth and thickness of all water, oil and gas formations.

OIL, GAS OR WATER RECORDS — CASING RECORD

FORMATION	CONTENT	FROM	TO	SIZE	PUT IN	PULLED OUT
Surface Hole	Water	0	350'	8 5/8"	350'	None
See Attached Log						

Describe in detail the manner in which the well was plugged, indicating where the mud fluid was placed and the method or methods used in introducing it into the hole. If cement or other plugs were used, state the character of same and depth placed, from feet to feet for each plug set.

Mud from 4470' to 340': Bridge at 340' and 20 Sacks of cement:

Mud to 40': Bridge at 40' and 10 Sacks of cement to surface.

RECEIVED
MAY 6
STATE CORPORATION COMMISSION

(If additional description is necessary, use BACK of this sheet)

Name of Plugging Contractor Rex & Morris Drilling Company

Address Box 334, El Dorado, Kansas

STATE OF Kansas, COUNTY OF Butler, ss.

C. E. McClure (employee of owner) or (owner or operator) of the above-described well, being first duly sworn on oath, says: That I have knowledge of the facts, statements, and matters herein contained and the log of the above-described well as filed and that the same are true and correct. So help me God.

(Signature) C. E. McClure

Box 334, El Dorado, Kansas
(Address)

SUBSCRIBED AND SWORN TO before me this 5th day of May, 19 58

Winifred E. Cruit
Winifred E. Cruit Notary Public.

My commission expires July 23, 1960

PLUGGING
SEC 11 T 18 R 24W
BOOK PAGE 97 LINE 8

15-135-00073-0000

Elevation 2322 RB
2319 DF

FLOYD WELL # 1

REX & MORRIS DRILLING CO. & BARBARA OIL CO.

Total Depth - 4470
Contractor - Rex & Morris Drilling Co.
Commenced - 4-12-58
Completed - 4-23-58
Initial Production - D & A

Location - C SE SE
Section 11-18S-24W
Ness County, Kansas.

Casing Record:
8 5/8 @ 350' w/ 175 sacks

FORMATION	DEPTH
Surface Hole	350
Shale & Red Rock	740
Shale, Red Bed & Sand	1300
Shale & Shells	1625
Shale & Shells and Salt	2130
Shale & Shells	2225
Lime & Shale	2615
Lime	2785
Lime & Shale	3325
Shale & Lime	3515
Lime	3615
Lime & Shale	3752
Lime	4223
Lime & Shale	4348
Lime	4470 TD

Log Schlumberger GR, LL, MLL

I hereby certify the foregoing statements are true and correct to the best of my knowledge and belief.

Rex & Morris Drilling Company

By Paul D. Young

Title Geologist

STATE OF KANSAS)
) SS.
COUNTY OF BUTLER)

Subscribed and sworn to before me, a Notary Public, this 5th day of May, 1958.

Winifred E. Druit

Winifred E. Druit-Notary Public

My commission expires July 23, 1960.

RECEIVED

PLUGGING
SEC 11 T 18 R 24W
BOOK PAGE 97 LINE