


STATE OF KANSAS
STATE CORPORATION COMMISSION

WELL PLUGGING RECORD

Give All Information Completely
Make Required Affidavit
Mail or Deliver Report to
Conservation Division
State Corporation Comm.
245 North Water
Wichita, KS 67202

NESS COUNTY County. Sec. 11 Twp. 18S Rge. 24W E/W
Location as "NE/CNW, SW" or footage from lines
NE NE SE

Lease Owner PICKRELL DRILLING COMPANY
Lease Name FLOYD "A" Well No. 1
Office Address 205 LITWIN BLDG. WICHITA, KS. 67202
Character of Well (Completed as Oil, Gas or Dry Hole)
DRY HOLE

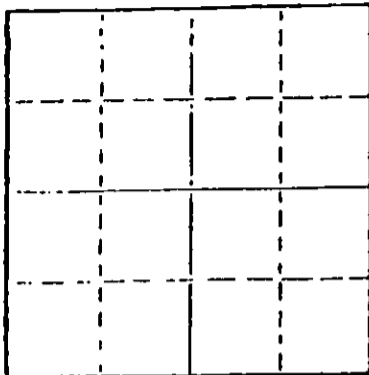

Locate well correctly on above
Section Plat

Date Well completed 2-4-80 19
Application for plugging filed 2-4-80 19
Application for plugging approved 2-4-80= 19
Plugging commenced 2-4-80 19
Plugging completed 2-4-80 19
Reason for abandonment of well or producing formation
DRY HOLE

If a producing well is abandoned, date of last production 19

Was permission obtained from the Conservation Division or
its agents before plugging was commenced? YES

Name of Conservation Agent who supervised plugging of this well Leo F. Massey
Producing formation _____ Depth to top _____ Bottom _____ Total Depth of Well 4380
Show depth and thickness of all water, oil and gas formations.

OIL, GAS OR WATER RECORDS

CASING RECORD

FORMATION	CONTENT	FROM	TO	SIZE	PUT IN	PULLED OUT
				8 5/8	354'	NONE

Describe in detail the manner in which the well was plugged, indicating where the mud fluid was placed and the method or methods used in introducing it into the hold. If cement or other plugs were used, state the character of same and depth placed, from _____ feet to _____ feet for each plug set.

70 sacks @ 870'
20 sacks @ 330'
10 sacks @ 40' w/solid bridge plug
5 sacks in rathole Comp. 6:00 AM 2-4-80

(If additional description is necessary, use BACK of this sheet)

Name of Plugging Contractor _____

STATE OF KANSAS COUNTY OF SEDGWICK
C.W. Sebitts (employee of owner) or (owner or operator)


of the above-described well, being first duly sworn on oath, says: That I have knowledge of the facts, statements, and matters herein contained and the log of the above-described well as filed and that the same are true and correct. So help me God.

BY C.W. Sebitts
(Signature) _____
205 LITWIN BLDG., WICHITA, KANSAS 67202
(Address)

SUBSCRIBED AND SWORN TO before me this 11th day of February, 1980

My commission expires 2-18-84

Jo Ann Sarver
Notary Public.

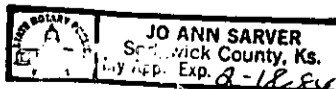

15-135-2754-0000
ROTARY DRILLING LOG

COMPANY: PICKRELL DRILLING COMPANY
 205 LITWIN BLDG. WICHITA, KANSAS 67202

LOCATION: FLOYD "A" #1
 NE Ne SE 11-18S-24W
 Ness County, Kansas

CONTRACTOR: **PICKRELL DRILLING COMPANY**
 Wichita, Kansas

Rotary Drilling Commenced 1-24-80
 Rotary Drilling Completed 2-4-80

CASING RECORD: Spud date 1-24-80 Surf. pipe 8 5/8 set at 354 w/185 sacks

LOG

(Figures indicate bottom of formation — measurements from top of rotary bushing.)

Top soil	50
Shale	120
Shale & hard stks	363
White shale & shell w/sand	405
Shale	1100
Shale	1105
Sand	1282
Sand & shale	1330
Shale	1617
Anhy	1650
Shale	1840
Shale & lime	2175
Shale	2242
Shale & lime stks	2310
Lime	2465
Shale & Lime	2645
Lime	2770
Lime & shale	2905
Lime & shale	3045
Lime & shale	3155
Lime & shale	3275
Lime	3400
Lime & shale	3560
Lime	3700
Lime & shale	3815
Lime & shale	3910
Lime	3995
Lime & shale	4070
Lime & shale	4140
Lime	4195
Lime & shale	4265
Lime & shale	4300

RECEIVED
 FEB 13 1980
 CONSERVATION DIVISION
 Wichita, Kansas

The undersigned, C.W. Sebitts, Attorney-in-Fact for PICKRELL DRILLING COMPANY, hereby certifies in behalf of said Company, that the above is a true and correct log of the formation encountered in drilling the above well as reflected by the Daily Drilling Reports.

PICKRELL DRILLING COMPANY
 By [Signature]
 Attorney-in-Fact

STATE OF KANSAS }
 COUNTY OF SEDGWICK } ss.:

On this 11th day of February, 19 80, before me the undersigned, a Notary Public, in and for the County and State aforesaid, personally appeared C. W. Sebitts, Partner & Attorney-in-Fact to me known to be the identical person who subscribed the name of PICKRELL DRILLING COMPANY to the foregoing instrument as its Attorney-in-Fact and acknowledged to me that he executed the same as his free and voluntary act and deed, and as the free and voluntary act and deed of such company, for the uses and purposes therein set forth.

Given under my hand and seal of office the day and year last above written.

My commission expires: 2-18-84
Jo Ann Sarver
 Jo Ann Sarver Notary Public

