


15-135-20772-0000

STATE OF KANSAS
STATE CORPORATION COMMISSION

Form CP-4

Give All Information Completely
Make Required Affidavit
Mail or Deliver Report to:
Conservation Division
State Corporation Commission
P. O. Box 17027
Wichita, Kansas 67217
NORTH

WELL PLUGGING RECORD

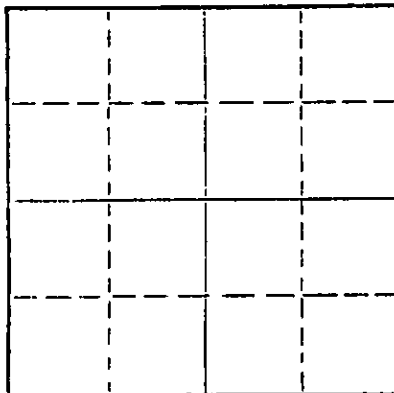

Locate well correctly on above
Section Plat

Ness County. Sec. 11 Twp. 18S. Rge. (E) 24 (W)
Location as "NE/CNW/SW" or footage from lines C NW SW
Lease Owner George A. Reed
Lease Name Rufenacht Well No. 1
Office Address 1223 Union Nat'l Bldg., Wichita, Kansas
Character of Well (completed as Oil, Gas or Dry Hole) Dry Hole
Date well completed 6-29 19 73
Application for plugging filed 6-29 19 73
Application for plugging approved 6-29 19 73
Plugging commenced 6-29 19 73
Plugging completed 6-29 19 73
Reason for abandonment of well or producing formation No commercial quantities of oil or gas encountered.
If a producing well is abandoned, date of last production 19
Was permission obtained from the Conservation Division or its agents before plugging was commenced? Yes

Name of Conservation Agent who supervised plugging of this well Leo Massey

Producing formation Depth to top Bottom Total Depth of Well 4395 Feet
Show depth and thickness of all water, oil and gas formations.

OIL, GAS OR WATER RECORDS

CASING RECORD

FORMATION	CONTENT	FROM	TO	SIZE	PUT IN	PULLED OUT
Surface Hole	Water	Surface	326	8-5/8"	318	None

Describe in detail the manner in which the well was plugged, indicating where the mud fluid was placed and the method or methods used in introducing it into the hole. If cement or other plugs were used, state the character of same and depth placed, from feet to feet for each plug set.

Fluid to 600', plug, 70 sx cement;
Fluid to 240', plug, 20 sx cement;
Fluid to 40', 1/2 sx hulls, 10 sx cement.

RECEIVED
STATE CORPORATION COMMISSION

JUL 5 1973

CONSERVATION DIVISION
Wichita, Kansas

(If additional description is necessary, use BACK of this sheet)

Name of Plugging Contractor D N B DRILLING, INC.

Address 701 First National Building, Wichita, Kansas 67202

STATE OF KANSAS, COUNTY OF ss.

JAMES L. DONELSON (employee of owner) or (owner or operator) of the above-described well, being first duly sworn on oath, says: That I have knowledge of the facts, statements, and matters herein contained and the log of the above-described well as filed and that the same are true and correct. So help me God.

(Signature)

701 First Nat'l Bldg., Wichita, Kansas
(Address)

SUBSCRIBED AND SWORN TO before me this 3rd day of July, 19 73

My commission expires August 25, 1976

Ella Priess

Notary Public.

15-135-20772-0000

DRILLERS' LOG

GEORGE A. REED
No. 1 Rufenacht
C NW SW, Sec. 11-18S-24W
Ness County, Kansas

Elevation: 2327

Commenced: 6-23-73
Completed: 6-29-73

Surface: 318' of 8-5/8"
cemented w/250 sx cement,
34 cc. 6-29-73

FORMATION

Depth

Surface Hole	0 - 326
Shale	326 - 430
Shale & Sand	430 - 972
Blaine Anhydrite	972 - 983
Shale & Sand	983 - 1608
Stone Corral Anhydrite	1608 - 1647
Shale & Salt	1647 - 2135
Shale & Lime	2135 - 2570
Lime & Shale	2570 - 3620
Lime	3620 - 4395 T.D.

RECEIVED
STATE CORPORATION COMMISSION

JUL 5 1973

CONSERVATION DIVISION
Wichita, Kansas

I do hereby certify that the foregoing statements are true and correct to the best of my knowledge and belief.

D N B DRILLING, INC.

James L. Donelson
JAMES L. DONELSON

STATE OF KANSAS: ss:

Subscribed and sworn to before me, the undersigned, a Notary Public in and for said state this 3rd day of July 1973.

My Commission Expires:
August 25, 1976

Ella Priess

Ella Priess, Notary Public

Ella Priess
STATE NOTARY PUBLIC
Sedgwick County, Kansas
My Com. Expires Aug. 25, 1976