


STATE OF KANSAS
STATE CORPORATION COMMISSION

WELL PLUGGING RECORD

Give All Information Completely
Make Required Affidavit
Mail or Deliver Report to
Conservation Division
State Corporation Comm.
245 North Water
Wichita, KS 67202

Ness County, Sec. 15 Twp. 18S Rge. 24W E/W
Location as "NE/CNW $\frac{1}{4}$ SW $\frac{1}{4}$ " or footage from lines _____
C SW/4 SE/4

Lease Owner Walters Drilling Company
Lease Name Schuler Well No. 1
Office Address 400 Insurance Building, Wichita, Ks
Character of Well (Completed as Oil, Gas or Dry Hole) _____
Dry Hole

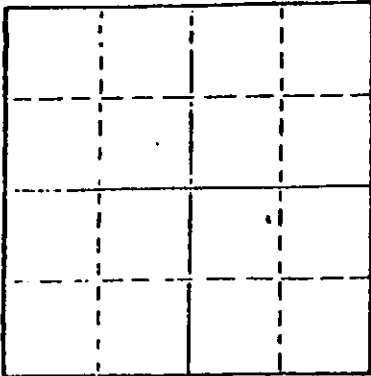

Locate well correctly on above
Section Plat

Date Well completed April 14 19 79
Application for plugging filed (verbally) April 14 19 79
Application for plugging approved (verbally) April 14 19 79
Plugging commenced April 14 19 79
Plugging completed April 14 19 79
Reason for abandonment of well or producing formation _____
No commercial quantity of oil or gas encountered _____
If a producing well is abandoned, date of last production _____
19 _____

Was permission obtained from the Conservation Division or
its agents before plugging was commenced? Yes

Name of Conservation Agent who supervised plugging of this well Leo Massey
Producing formation _____ Depth to top _____ Bottom _____ Total Depth of Well 4400'
Show depth and thickness of all water, oil and gas formations.

OIL, GAS OR WATER RECORDS

CASING RECORD

FORMATION	CONTENT	FROM	TO	SIZE	PUT IN	PULLED OUT

Describe in detail the manner in which the well was plugged, indicating where the mud fluid was placed and the method or methods used in introducing it into the hold. If cement or other plugs were used, state the character of same and depth placed, from _____ feet to _____ feet for each plug set.

T.D. 4400'
Set 1st plug at 550' with 70 sacks
2nd plug at 300' with 20 sacks
3rd plug at 40' solid bridge with 10 sacks.
Cemented with 50/50 posmix, 6% gel.
Plug was down at 3:45 p.m., 4-14-79.

RECEIVED
STATE CORPORATION COMMISSION

APR 20 1979

CONSERVATION DIVISION
Wichita, Kansas

(If additional description is necessary, use BACK of this sheet)

Name of Plugging Contractor Abercrombie Drilling, Inc.

STATE OF Kansas COUNTY OF Sedgwick, ss.
Jack L. Partridge, Asst. Sec.-Treas. (employee of owner) or (owner or operator)
of the above-described well, being first duly sworn on oath, says: That I have knowledge of
the facts, statements, and matters herein contained and the log of the above-described well
as filed and that the same are true and correct. So help me God.

(Signature) Jack L. Partridge
801 Union Center, Wichita, Kansas
(Address)

SUBSCRIBED AND SWORN TO before me this 19th day of April, 19 79

SHERRIE L. BROOKS
Sedgwick County, KS
My Appt. Exp. 8-21-82

Sherrie L. Brooks
Sherrie L. Brooks Notary Public.

My commission expires 8-21-82

CONTRACTOR'S WELL LOG

OPERATOR: Walters Drilling Company
 CONTRACTOR: Abercrombie Drilling, Inc.
 WELL NAME: Schuler #1
 LOCATION: C SW/4 SE/4, Section 15-18S-24W
 Ness County, Kansas
 SPUD DATE: April 06, 1979
 COMPLETION DATE: April 14, 1979

0	318	Sand and shale
318	1590	Shale and sand
1590	1623	Anhydrite
1623	4253	Shale
4253	4267	Lime
4267	4359	Shale
4359	4400	Lime
	4400	Rotary Total Depth

Spud hole at 12:15 p.m., April 06, 1979. Drilled 318' of 12 1/4" hole. Ran 8 joints of new 8-5/8" - 24# 8rd thd casing. Set at 315' K.B. with 200 sacks of common cement, 3% Ca.Cl., 2% gel. Cement did circulate. Plug was down at 6:45 p.m., April 06, 1979.

T.D. 4400'. Set 1st plug at 550' with 70 sacks, 2nd plug at 300' with 20 sacks, 3rd plug at 40' solid bridge with 10 sacks. Cemented with 50/50 posmix, 6% gel. Plug was down at 3:45 p.m., April 14, 1979.

SAMPLE TOPS:

Anhydrite 1590'
 B/Anhydrite 1623'

RECEIVED
 STATE CORPORATION COMMISSION

APR 20 1979

STATE OF KANSAS)
) ss
 COUNTY OF SEDGWICK)

CONSERVATION DIVISION
 Wichita, Kansas

Jack L. Partridge, Assistant Secretary-Treasurer of Abercrombie Drilling, Inc., does hereby state that the above and foregoing is a true and correct copy of the log of the Schuler #1, C SW/4 SE/4, Section 15-18S-24W, Ness County, Kansas.

ABERCROMBIE DRILLING, INC.

BY Jack L. Partridge
 Jack L. Partridge
 Assistant Secretary-Treasurer

Subscribed and sworn to before me, a Notary Public, in and for the county and state aforesaid, as of this 19th day of April, 1979.



Sherrie L. Brooks
 Sherrie Brooks, Notary Public

My commission expires 8-21-82.