


15-015-30089-0000

WELL PLUGGING RECORD

Give All Information Completely  
Make Required Affidavit  
Mail or Deliver Report to:  
Conservation Division  
State Corporation Commission  
212 No. Market  
Wichita, Kansas

NORTH

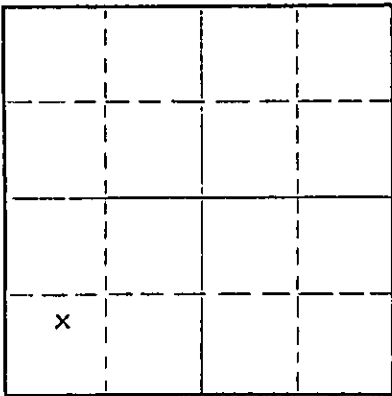

Locate well correctly on above  
Section Plat

Butler County, Sec. 11 Twp. 26 Rge. 4 (E) (W)  
Location as "NE/CNWxSWx" or footage from lines. 1/2 S 1/4 NW-NW-SW  
Lease Owner W.F. Braden & Son  
Lease Name Stephenson Well No. 1  
Office Address 215 S. Star El Dorado, Kansas  
Character of Well (completed as Oil, Gas or Dry Hole) oil well  
Date well completed 10-6-66 19  
Application for plugging filed 8-10-67 19  
Application for plugging approved 8-11-67 19  
Plugging commenced 9-11-67 19  
Plugging completed 9-14-67 19  
Reason for abandonment of well or producing formation depleted

If a producing well is abandoned, date of last production 19  
Was permission obtained from the Conservation Division or its agents before plugging was commenced? yes

Name of Conservation Agent who supervised plugging of this well Herman Justice  
Producing formation \_\_\_\_\_ Depth to top \_\_\_\_\_ Bottom \_\_\_\_\_ Total Depth of Well 1980 Feet  
Show depth and thickness of all water, oil and gas formations.

OIL, GAS OR WATER RECORDS

CASING RECORD

FORMATION	CONTENT	FROM	TO	SIZE	PUT IN	PULLED OUT
				7"	1803'	1501'
				5 1/2"	1980'	1820'

Describe in detail the manner in which the well was plugged, indicating where the mud fluid was placed and the method or methods used in introducing it into the hole. If cement or other plugs were used, state the character of same and depth placed, from \_\_\_\_\_ feet to \_\_\_\_\_ feet for each plug set.

Fill hole with sand from 1980' to 1960' and dump 5 sacks of cement

Set 15' rock bridge from 200' to 185' and dump 5 cubic yards of ready mix concrete

Mud hole to 30' and dump 1 cubic yards of ready mix concrete

SEP 25 1967

9-25-67

(If additional description is necessary, use BACK of this sheet)  
Name of Plugging Contractor Flint Engineering and Const. Co.  
Address 2375 W. Central El Dorado, Kansas

STATE OF Kansas, COUNTY OF Butler, ss.

(employee of owner) or (owner or operator) of the above-described well, being first duly sworn on oath, says: That I have knowledge of the facts, statements, and matters herein contained and the log of the above-described well as filed and that the same are true and correct. So help me God.

(Signature) *Ronald R. Hanson*

SUBSCRIBED AND SWORN TO before me this 21 day of Sept., 1967

(Address) *Ronald R. Hanson*

My commission expires Sept. 27, 1967

Notary Public.

15-015-30089-0900 COPY

KANSAS GEOLOGICAL SOCIETY  
KANSAS WELL LOG BUREAU - KANSAS WELL SAMPLE BUREAU  
KANSAS GEOLOGICAL SOCIETY BUILDING  
808 EAST MURDOCK - WICHITA, KANSAS

COMPANY W. P. BRADEN & SON

SEC. 11 T. 26 S. 4E  
COR. NW NW SW

FARM Stephenson

NO. 1

TOTAL DEPTH 2401

COMM. 9-26-66

COMP. 10-6-66


SHOT OR TREATED

CONTRACTOR Triangle Drilg.

ISSUED 11-19-66

COUNTY Butler

KANSAS

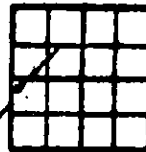

SABING

20  
18  
12  
12

10

5/8"

149' w/100 SX

6

5 1/2

1464-175 sd

ELEVATION 1345' KB

PRODUCTION DRY (Arb)

FIGURES INDICATE BOTTOM OF FORMATIONS

0	30 Soil and clay
30	45 Shale and Lime
45	125 Lime
125	137 Shale and Lime
127	445 Lime and Shale
445	630 Shale w/ Lime
630	800 Lime and Shale
800	1130 Shale and Lime streaks
1130	1960 Lime and Shale
1960	1975 Lime
1975	2338 Lime and Shale
2338	2402 Arbuckle Lime

TOPS: SAMPLE

Base Lansing	1818
Lansas City	1950
Base Kansas City	2109
Alt	2180
Pawnee	2210
Fort Scott	2256
Cherokee	2302
Arbuckle	2338

F.B-1980

Prof - 1968 - 1972