


15-071-20159-0000

STATE OF KANSAS  
STATE CORPORATION COMMISSION

WELL PLUGGING RECORD

Give All Information Completely  
Make Required Affidavit  
Mail or Deliver Report to  
Conservation Division  
State Corporation Comm.  
245 North Water  
Wichita, KS 67202

Greeley County. Sec. 36 Twp. 16-S Rge. 40 E/W  
Location as "NE/CNW $\frac{1}{4}$ SW $\frac{1}{4}$ " or footage from lines \_\_\_\_\_  
1980' FSL & 1980' FWL  
Lease Owner Wayman W. Buchanan  
Lease Name Helen M. Green, etal Well No. 1  
Office Address 400 Bldg. of the Southwest, Midland, TX  
Character of Well (Completed as Oil, Gas or Dry Hole) 79701  
Dry Hole.

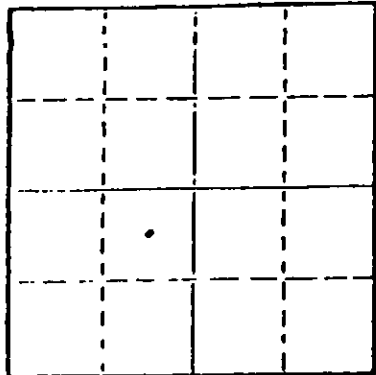

Locate well correctly on above  
Section Plot

Date Well completed 10-1-78 19  
Application for plugging filed Verbal 19  
Application for plugging approved 11-13- 1978  
Plugging commenced 11-7 1978  
Plugging completed 11-8 1978  
Reason for abandonment of well or producing formation \_\_\_\_\_

Dry hole.  
If a producing well is abandoned, date of last production \_\_\_\_\_ 19

Was permission obtained from the Conservation Division or its agents before plugging was commenced? yes-verbal

Name of Conservation Agent who supervised plugging of this well Gilbert Balthazon  
Producing formation None Depth to top ---- Bottom ---- Total Depth of Well 4534'  
Show depth and thickness of all water, oil and gas formations.

OIL, GAS OR WATER RECORDS

CASING RECORD

FORMATION	CONTENT	FROM	TO	SIZE	PUT IN	PULLED OUT
Winfield	water	2937'	2951'	4-1/2"	4534'	0'
Fort Riley	water	2961'	2971'			
Topeka	water	3781'	3787'			
Kansas City Limestone	water	4378'	4386'			

Describe in detail the manner in which the well was plugged, indicating where the mud fluid was placed and the method or methods used in introducing it into the hold. If cement or other plugs were used, state the character of same and depth placed, from \_\_\_\_\_ feet to \_\_\_\_\_ feet for each plug set.

CIPB on wireline, @4250', 10' cmt., set on plug. PBTD 4240'. Retrieval "D" pkr., w/Model "B" plug, set @3650', on wireline, 10' Frac sand on top of plug. Squeezed perfs. 2937-2971', w/150 sxs. of cmt. Cleaned out cmt. to 2955'. Set CIBP @2820', w/20' of Frac sand on plug. Spotted 20 sxs. of cmt. @300' back to 180'. Spotted 10 sxs. plug, 60' back to surface. Cut-off csg. & welded on plate.

(If additional description is necessary, use BACK of this sheet)

Name of Plugging Contractor J. W. Gibson Well Service Co.

STATE OF Texas COUNTY OF Midland, ss.  
Don C. Bennett, Agent (employee of owner) or (owner or operator)  
of the above-described well, being first duly sworn on oath, says: That I have knowledge of the facts, statements, and matters herein contained and the log of the above-described well as filed and that the same are true and correct. So help me God.

(Signature) Don C. Bennett  
400 Bldg. of the Southwest, Midland, TX  
(Address) 79701

SUBSCRIBED AND SWORN TO before me this 13th day of December, 19 78

Nancy Donslow  
Notary Public.

My commission expires 6-79

RECEIVED  
STATE CORPORATION COMMISSION  
DEC 15 1978  
12-15-78  
CONSERVATION DIVISION  
Wichita, Kansas