

WELL PLUGGING RECORD

Give All Information Completely
Make Required Affidavit
Mail or Deliver Report to
Conservation Division
State Corporation Comm.
245 North Water
Wichita, KS 67202

Rush County Sec. 29 Twp. 16s Rge. 19 XY/W
Location as "NE/CNW/SW" or footage from lines _____
NE SE NE

Lease Owner Rincon Operating Company
Lease Name Littler Well No. #1
Office Address 1580 Lincoln St. #700 Denver, CO 80203

Character of Well (Completed as Oil, Gas or Dry Hole) _____
Dry Hole

Date Well completed April 23, 1981
Application for plugging filed April 23 1981
Application for plugging approved April 23 1981
Plugging commenced 8:00 P.M. April 23 1981
Plugging completed 9:30 P.M. April 23 1981


Reason for abandonment of well or producing formation _____
no commercial production

If a producing well is abandoned, date of last production _____
19 _____

Was permission obtained from the Conservation Division or its agents before plugging was commenced? yes

Name of Conservation Agent who supervised plugging of this well Marion Schmidt
Producing formation _____ Depth to top _____ Bottom _____ Tl. Depth of Well _____
Show depth and thickness of all water, oil and gas formations.

locate well correctly
on above
Section Plot

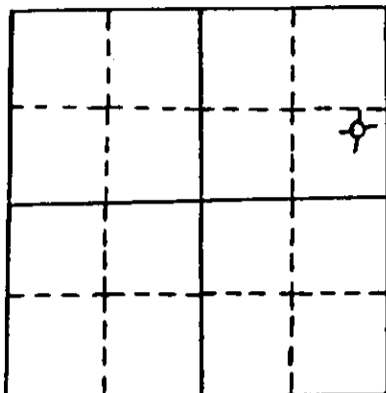

OIL, GAS OR WATER RECORDS

CASING RECORD

FORMATION	CONTENT	FROM	TO	SIZE	PUT IN	PULLED OUT
surface casing	common	0'	599.18'	8 5/8"	599.18'	0'

Describe in detail the manner in which the well was plugged, indicating where the mud fluid was placed and the method or methods used in introducing it into the hold. If cement or other plugs were used, state the character of same and depth placed, from _____ feet to _____ feet for each plug set.

Plug #1 @ 660' with 65 sxs

Plug #2 @ 270' with 30 sxs

Plug #3 @ 40' with 10 sxs

5 sxs in rathole

Total 110 sxs 50-50 poz 6% gel

P.D. @ 9:30 P.M. 4-23-81

STATE CORPORATION COMMISSION
Wichita, Kansas

(If additional description is necessary, use BACK of this sheet)

Name of Plugging Contractor Pioneer Drilling Company, Inc.
308 West Mill Plainville, KS 67663

STATE OF Colorado COUNTY OF Denver, ss.

Clarence H. Brown (employee of owner) or (owner or operator) of the above described well, being first duly sworn on oath, says: That I have knowledge of the facts, statements, and matters herein contained and the log of the above described well is filed and that the same are true and correct. So help me God.

(Signature) Clarence H. Brown

(Address) 1580 Lincoln Street #700

Denver, Colorado 80203

SUBSCRIBED AND SWORN TO before me this 15 day of May, 1981

My commission expires 2/25/85

Nealie A. Ulbricht
Notary Public

15-165-20828-0000

WELL LOG

OPERATOR: Rincon Operating Company

WELL NAME: Littler #1 LOCATION: NE SE NE 29-16s-19W

COUNTY: Rush STATE: Kansas

WELL COMMENCED: April 13, 1981 WELL COMPLETED: April 23, 1981

ELEVATION: 2071' K.B. TOTAL DEPTH: 3860'

PRODUCTION: D & A RIG NO: #3

CASING - 8 5/8": 15 JTs. new 24# Tally @ 592.18' Set @ 599.18' Cemented with 300 sxs common
3 3/4 cc did circ P.D. @ 3:30 A.M. 4-14-81
5 1/2": _____

ALL MEASUREMENTS TAKEN FROM THE TOP OF ROTARY BUSHING:

FROM	TO	FORMATION	DEVIATION FROM VERTICAL	REMARKS:
0'	602'		602' - 0 - degree	
602'	800'	shales and sand		
800'	1321'	sand and shale		
1321'	1347'	Anhydrite		
1347'	1500'	shale		
1500'	2055'	shales		
2055'	2200'	shales	2190' - 2 1/2 - degree	
2200'	2435'	lime and shale		
2435'	2630'	shales and lime		
2630'	2795'	shales and lime		
2795'	2995'	shale and lime		
2995'	3145'	shales and lime		
3145'	3280'	shales and lime		
3280'	3418'	lime and shale		
3418'	3485'	shale and lime		
3485'	3512'	lime and shale		
3512'	3614'	lime and shale		
3614'	3695'	lime and shale		
3695'	3769'	lime and shale		
3769'	3830'	lime and shale	3830' - 2 1/2 - degree	
3830'	3838'	Arbuckle		
3838'	3845'	Arbuckle	3845' - 1 - degree	
3845'	3860'	Arbuckle		
3860'	RTD			

RECEIVED
STATE CORPORATION COMMISSION

CONSERVATION DIVISION
Wichita, Kansas

STATE OF KANSAS
COUNTY OF _____

The undersigned hereby certifies that to the best of his knowledge and belief, the above facts are true and correct.

PIONEER DRILLING CO., INC.

By _____

SUBSCRIBED AND SWORN TO, BEFORE ME, This 1st day of July, 1981

Sharon Garvert
NOTARY PUBLIC

