


STATE OF KANSAS
STATE CORPORATION COMMISSION

Form CP-4

WELL PLUGGING RECORD

Give All Information Completely
Make Required Affidavit
Mail or Deliver Report to:
Conservation Division
State Corporation Commission
212 No. Market
Wichita, Kansas

Hodgeman County, Sec. 22 Twp. 22 Rge. 23 (E) (W)
Location as "NE/CNW/SW" or footage from lines C NE NE
Lease Owner Mull Drilling Company, Inc.
Lease Name Scothorn Well No. 1
Office Address 1625 Wichita Plaza Building Wichita, Kansas 67210
Character of Well (completed as Oil, Gas or Dry Hole)
Date well completed 19
Application for plugging filed 9-23-66 19
Application for plugging approved 9-24-66 19
Plugging commenced 10-1-66 19
Plugging completed 10-7-66 19
Reason for abandonment of well or producing formation

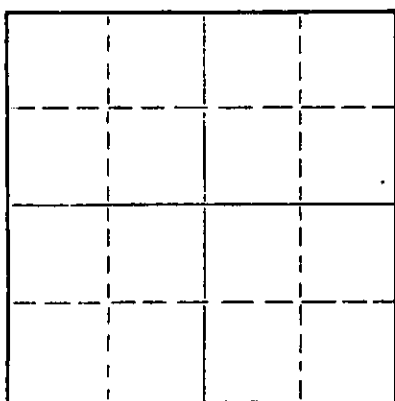

Locate well correctly on above Section Plat

If a producing well is abandoned, date of last production 19
Was permission obtained from the Conservation Division or its agents before plugging was commenced? Yes

Name of Conservation Agent who supervised plugging of this well Edgar J. Eves
Producing formation Depth to top Bottom Total Depth of Well 4568 Feet
Show depth and thickness of all water, oil and gas formations.

OIL, GAS OR WATER RECORDS

CASING RECORD

FORMATION	CONTENT	FROM	TO	SIZE	PUT IN	PULLED OUT
				8 5/8	382	None
				4 1/2	None	2537

Describe in detail the manner in which the well was plugged, indicating where the mud fluid was placed and the method or methods used in introducing it into the hole. If cement or other plugs were used, state the character of same and depth placed, from feet to feet for each plug set.

Moved in. Cleaned out cellar. Sanded to 4500'. Dumped 5 sacks of cement. Rigged up unit. Working pipe.
Working pipe. Shot pipe at 3900' - 3500' - 3200' - 3000' - 2700' - 2600' and 2520'.
Working pipe. Moved in line machine. Rigging up same.
Working pipe. Pulling pipe.
Pulling pipe. Tearing down line machine.
Plugging well. Bailing hole down. Well making water. Pumped 10 sacks of mud and 25 sacks of cement at 390'. Pumped 5 sacks of mud and 10 sacks of cement for cap.

(If additional description is necessary, use BACK of this sheet)

Name of Plugging Contractor Forbes Casing Pulling, Inc.
Address P. O. Box 221 Great Bend, Kansas 67530

STATE OF Kansas, COUNTY OF Barton ss.
J. O. Forbes (employee of owner) or (owner or operator) of the above-described

well, being first duly sworn on oath, says: That I have knowledge of the facts, statements, and matters herein contained and the log of the above-described well as filed and that the same are true and correct. So help me God.

(Signature) J. O. Forbes
P. O. Box 221 Great Bend, Kansas
(Address)

SUBSCRIBED AND SWORN TO before me this 11 day of October, 1966

My commission expires May 27, 1969

Notary Public.

ROTARY DRILLING LOG

OPERATOR: Rains & Williamson Oil Co.,
 Mull Drilling Co., Inc., and
 Wilcox Oil Co.
 No. 1 Scothorn
 C NE NE Sec. 22-22S-23W
 Hodgeman Co., Kansas

CONTRACTOR: Rains & Williamson
 Oil Co.
 COMMENCED: 1-4-64
 COMPLETED: 1-16-64

REMARKS: Set 8-5/8" casing at
 382' with 180 sacks
 quick set cement.
 Set 4-1/2" casing at
 4568' with 125 sacks
 cement.

Formations:

Surface Clay	20'
Shale & Shells	125'
Shale	250'
Shale & Sand	310'
Shale	381'
Shale & Shells	680'
Red Bed	895'
Anhydrite	910'
Shale	1000'
Sand	1185'
Shale & Shells	1340'
Shale & Red Bed	1530'
Anhydrite	1565'
Shale	2280'
Shale & Lime	2380'
Lime & Shale	3380'
Shale & Lime	3970'
Lime & Shale	4085'
Lime	4120'
Lime & Shale	4545'
Lime	4566'
Lime & Shale	4571'
Rotary Total Depth	4571'

RECEIVED
 OCT 20 1964
 RAINSON DIVISION

We certify the above log is true
 and correct to the best of our
 knowledge and belief.

RAINS & WILLIAMSON OIL CO.

Wilson Rains
 Wilson Rains
 Partner

Subscribed and sworn to before me, a Notary Public in and for the State
 of Kansas, County of Sedgwick, this 20th day of January, 1964

My Commission Expires:
 August 14, 1966

Sandra Ames
 Sandra Ames, Notary Public

