
15-135-22031-0000

FORM CP-4

STATE OF KANSAS
STATE CORPORATION COMMISSION

WELL PLUGGING RECORD

Give All Information Completely
Make Required Affidavit
Mail or Deliver Report to
Conservation Division
State Corporation Comm.
245 North Water
Wichita, KS 67202

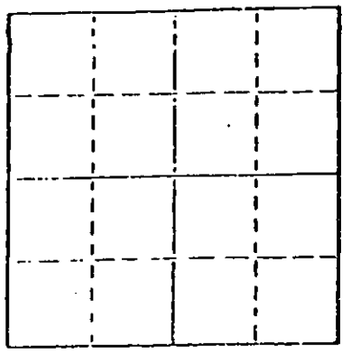

Locate well correctly on above Section Plat

Ness County. Sec. 32 Twp. 20S Rge. 21 E/W
Location as "NE/CNW¼SW¼" or footage from lines
200' W of C SW NE NW
Lease Owner Pendleton Land & Exploration, Inc.
Lease Name Diven Well No. #1
Office Address 23 Inverness Way East, Englewood, Colo. 80112
Character of Well (Completed as Oil, Gas or Dry Hole)
Dry Hole
Date Well completed 6-9-81 19
Application for plugging filed 6-9-81 19
Application for plugging approved 6-9-81 19
Plugging commenced 6-9-81 19
Plugging completed 6-9-81 19
Reason for abandonment of well or producing formation
Commercial quantities of oil not found
If a producing well is abandoned, date of last production
19.
Was permission obtained from the Conservation Division or its agents before plugging was commenced? Yes

Name of Conservation Agent who supervised plugging of this well Marion Schmidt
Producing formation Depth to top Bottom Total Depth of Well 4410'
Show depth and thickness of all water, oil and gas formations.

OIL, GAS OR WATER RECORDS — CASING RECORD

FORMATION	CONTENT	FROM	TO	SIZE	PUT IN	PULLED OUT
				8 5/8"	504'	None

Describe in detail the manner in which the well was plugged, indicating where the mud fluid was placed and the method or methods used in introducing it into the hold. If cement or other plugs were used, state the character of same and depth placed, from feet to feet for each plug set.

Plug @ 740' w/65 sx.
Plug @ 270' w/30 sx.
Plug @ 40' w/10 sx.
Rat Hole 5 sx.

RECEIVED
STATE CORPORATION COMMISSION
JUL - 1 1981
CONSERVATION DIVISION
Wichita, Kansas

(If additional description is necessary, use BACK of this sheet)
Name of Plugging Contractor Silverado Drilling, Inc.

STATE OF Kansas COUNTY OF Sedgwick, ss.
Joseph B. Brungardt, Jr., Acct. of Silverado Drilling, Inc. (employee of owner) or (owner or operator) of the above-described well, being first duly sworn on oath, says: That I have knowledge of the facts, statements, and matters herein contained and the log of the above-described well as filed and that the same are true and correct. So help me God.

(Signature) Joseph B. Brungardt Jr.
435 Page Court, 220 W. Douglas, Wichita, Kans. 67202
(Address)

SUBSCRIBED AND SWORN TO before me this 16 day of June, 1981

Juanita M. Green
Juanita M. Green Notary Public.

My commission expires 10-4-83

JUANITA M. GREEN NOTARY PUBLIC

15-135-22031-0000

DRILLER'S LOG

COMPANY: Pendleton Land & Exploration, Inc. SEC. 32 T. 20S R. 21W

LOC. 200' W of C SW NE NW

WELL NAME: Diven #1 COUNTY: Ness

RIG NO. #8

TOTAL DEPTH 4410' ELEVATION

COMMENCED: 5-28-81 COMPLETED: 6-9-81

CONTRACTOR: Silverado Drilling, Inc.

CASING RECORD:

SURFACE: 8 5/8" @ 504' w/275 sx. common, 3% cc., 2% gel.

PRODUCTION: D&A

LOG

(Figures Indicate Bottom of Formations)

Sand & Clay	225
Shale	2045
Sand & Shale	2262
Shale & Lime	2610
Lime & Shale	3276
Shale & Lime	3580
Lime & Shale	3835
Shale & Lime	3912
Lime & Shale	4082
Shale & Lime	4225
Lime & Shale	4286
Lime	4312
Lime & Shale	4410
ROTARY TOTAL DEPTH	4410

RECEIVED
STATE CORPORATION COMMISSION
JUL - 1 1981
CONSERVATION DIVISION
Wichita, Kansas

STATE OF Kansas)
COUNTY OF Sedgwick) SS:

I, Joseph B. Brungardt, Jr., Acct. of Silverado Drilling, Inc. upon oath state that the above and foregoing is a true and correct copy of the log of the Diven #1 well.

Joseph B. Brungardt, Jr.

Subscribed and sworn to before me this 16 day of June, 1981.

My Appointment Expires:
10-4-83

Juanita M. Green