

STATE OF KANSAS  
STATE CORPORATION COMMISSION

WELL PLUGGING RECORD

Give All Information Completely  
Make Required Affidavit  
Mail or Deliver Report to:  
Conservation Division  
State Corporation Commission  
100 Bitting Building  
Wichita, Kansas


OR

FORMATION PLUGGING RECORD

Strike out upper line  
when reporting plugging  
off formations.

Ellis County Sec. 5 Twp. 11 Rge. (E) 20 (W)  
Location as "NE¼NW¼SW¼" or footage from lines. NE 1/4 SW  
Lease Owner Mid-Continent Petroleum Corporation & Barnett Drlg. Co.  
Lease Name H. A. Fischer "A" Well No. 1  
Office Address Box 1362, Wichita 1, Kansas  
Character of Well (completed as Oil, Gas or Dry Hole) Dry hole  
Date well completed 9-28 1947  
Application for plugging filed 9-29 1947  
Application for plugging approved 9-30 1947  
Plugging commenced 9-28 1947  
Plugging completed 9-29 1947  
Reason for abandonment of well or producing formation Dry hole

NORTH

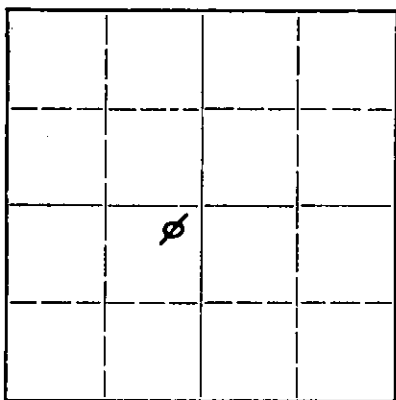

Locate well correctly on above  
Section Plat

If a producing well is abandoned, date of last production 19  
Was permission obtained from the Conservation Division or its agents before plugging was commenced? Yes

Name of Conservation Agent who supervised plugging of this well C. D. Stough, Hays, Kansas  
Producing formation none Depth to top Bottom Total Depth of Well Feet

Show depth and thickness of all water, oil and gas formations.

OIL, GAS OR WATER RECORDS

CASING RECORD

Formation	Content	From	To	Size	Put In	Pulled Out
				8 5/8"	124'	none

Describe in detail the manner in which the well was plugged, indicating where the mud fluid was placed and the method or methods used in introducing it into the hold. If cement or other plugs were used, state the character of same and depth placed, from feet to feet for each plug set.

Hole filled with heavy rotary mud from 195-3629'  
Wooden plug set at 125'  
15 sacks cement put in through drill pipe from 145-195'  
Hole filled with heavy rotary mud from 35-145'  
Wooden plug set at 35'  
10 sacks cement to top of surface casing 5-35'  
Cellar will be filled with dirt

STATE OF KANSAS  
COMMISSIONER  
007-6-1947  
CONSERVATION

(If additional description is necessary, use BACK of this sheet)

Correspondence regarding this well should be addressed to Lloyd Snyder  
Address Box 1362, Wichita 1, Kansas

STATE OF Kansas COUNTY OF Sedgewick, ss.  
S. K. Mc Lanahan (employee of owner) or (owner or operator) of the above-described well,  
being first duly sworn on oath, says: That I have knowledge of the facts, statements, and matters herein contained and the log of the above-described well as filed and that the same are true and correct. So help me God.

(Signature) S. K. Mc Lanahan  
Box 1362, Wichita, 1, Kan (Address)

SUBSCRIBED AND SWORN to before me this 6 day of October, 1947

Mae Resco  
Notary Public.

My commission expires Mar. 28, 1949

PLUGGING  
FILE SEC 5 T 11 R 20W  
BOOK PAGE 136 LINE 22

COMPANY - Barnett Drilling Company and  
Mid-Continent Petroleum Corp.  
FARM - H. A. Fischer "A" No. 1

Sec. 5 T. 11S R. 20W  
NE-NE SW

Total depth - 3699'  
Comm. 9-12-47 Comp. 9-28-47  
Shot or treated  
Contractor - Barnett Drilling Company


COUNTY - Ellis

Elevation 2052

CASING: 8 5/8" 24# L.W.S.H. 190'

Production - Dry hole

Surface clay	0	40	
Shale	40	75	
Sand	75	100	
Shale & shells	100	185	
Lime	185	198	
Shale & lime	198	400	
Shale	400	570	
Shale & shells	570	1000	
Sand	1000	1200	
Shale & shells	1200	1500	
Anhydrite	1500	1540	
Shale	1540	1580	
Shale & shells	1580	2100	
Lime	2100	2165	
Shale & lime	2165	2255	
Lime	2255	2320	
Shale & lime	2320	2840	
Shale	2840	2925	
Shale & lime	2925	3097	
Lime (Topeka)	3097	3140	Top of Topeka line 3097'
Lime & shale	3140	3337	Top of Heebner 3302'
Lime, Kansas City	3337	3600	
Conglomerate & chert	3600	3648	
Knuckle lime	3648	3699	
TOTAL DEPTH	3699		

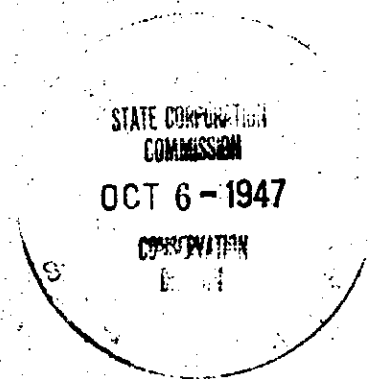

**PLUGGING**  
FILE SEC 5 T 11 R 20W  
BOOK PAGE 136 LINE 22