


STATE OF KANSAS  
STATE CORPORATION COMMISSION

WELL PLUGGING REPORT

Give All Information Completely  
Required Affidavit  
or Deliver Report to  
Conservation Division  
State Corporation Comm.  
245 North Water  
Wichita, KS 67202

Rooks County, Sec. 1 Twp. 6 Rge. 18 XXW  
Location as "NE/CNW/SW" or footage from lines  
890' FSL & 2310' FEL in SE $\frac{1}{4}$   
Lease Owner Gerry L. Johnson - Johnson Oil Company  
Lease Name Southard Well No. 1  
Office Address Rt. 3, Box 35, Phillipsburg, Ks. 67661  
Character of Well (Completed as Oil, Gas or Dry Well)

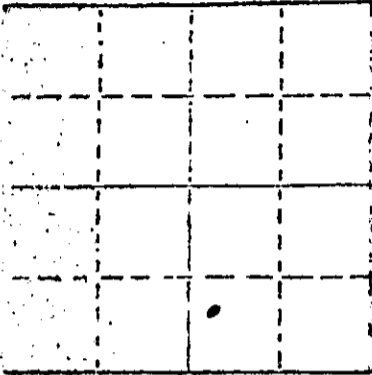

Locate well correctly on above  
Section Plot

Oil  
Date Well completed 2-14-83  
Application for plugging filed 5/3/84  
Application for plugging approved (Verbal) 5/8/84  
Plugging commenced 5/10/84  
Plugging completed 5/10/84  
Reason for abandonment of well or producing formation  
Production dropped - Not economical  
If a producing well is abandoned, date of last production  
April 1983

Was permission obtained from the Conservation Division or its agents before plugging was commenced? Yes

Name of Conservation Agent who supervised plugging of this well Carl Goodrow  
Producing formation LKC, Topkea Depth to top 2882 Bottom 3163 Total Depth of Well 3289  
Show depth and thickness of all water, oil and gas formations.

OIL, GAS OR WATER RECORDS

CASING RECORDS

FORMATION	CONTENT	FROM	TO	SIZE	PUT IN	PULLED
				8 5/8	273	Not pulled
				4 1/2	3289	Not pulled

Describe in detail the manner in which the well was plugged, indicating where the plug was placed and the method or methods used in introducing it into the hold. If cement plugs were used, state the character of same and depth placed, from \_\_\_\_\_ feet to \_\_\_\_\_ feet for each plug set.

Mixed 60 sacks of 50/50 poz, 6% salt, & 3% C.C. with 4 sacks of bulls and 1 sack of gel. Displaced to 2832 with 12 sacks of gel and followed with 50 sacks of cement. Squeezed at 500 lbs. Mixed 2 sacks 50/50 poz and pumped down between casing & surface pipe, and pressured to 300 lbs. Plug down at 10:45 A.M.

RECEIVED  
STATE CORPORATION COMMISSION  
MAY 14 1984  
CONSERVATION DIVISION  
Wichita, Kansas

(If additional description is necessary, use BACK of this sheet)

Name of Plugging Contractor Pfeifer-Sharpe, Inc., Box 386, Hill City, Ks. 67642  
# 6967

STATE OF Kansas COUNTY OF Graham, ss.

Bill Daily (employee of owner) or ~~XXXXXXXXXXXXXXXXXXXX~~  
of the above-described well, being first duly sworn on oath, says: That I have knowledge of the facts, statements, and matters herein contained in the log of the above-described well, and that the same are true and correct. So help me God.

(Signature)

Bill Daily

P. O. Box 386, Hill City, Kansas 67642  
(Address)

SUBSCRIBED AND SWORN TO before me this 11th day of May, 1984

Debra L Pfeifer-Wentz  
Notary Public

My commission expires May 12, 1986

