


STATE OF KANSAS  
STATE CORPORATION COMMISSION

WELL PLUGGING RECORD

Give All Information Completely  
Make Required Affidavit  
Mail or Deliver Report to:  
Conservation Division  
State Corporation Commission  
211 No. Broadway  
Wichita, Kansas

\_\_\_\_\_ NESS \_\_\_\_\_ County. Sec. 6 Twp. 10N Rge. 26E (E) \_\_\_\_\_ (W)  
Location as "NE/CNW/SW" or footage from lines NO NO  
Lease Owner Cimarron Exploration xxxxxx Inc.  
Lease Name Salsor Well No. 1  
Office Address Box 1142 Liberal, Kansas  
Character of Well (completed as Oil, Gas or Dry Hole) Oil  
Date well completed \_\_\_\_\_ 19\_\_\_\_  
Application for plugging filed 5-25 19 65  
Application for plugging approved 5-28 19 65  
Plugging commenced 6-28 19 65  
Plugging completed 6-30 19 65  
Reason for abandonment of well or producing formation Non commercial

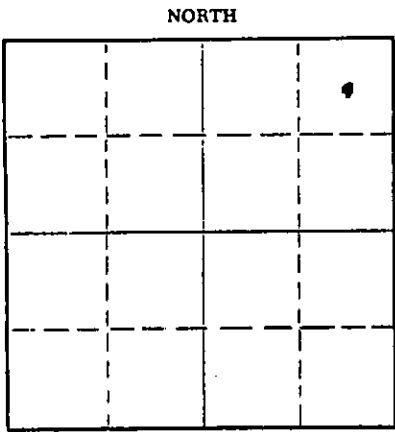

Locate well correctly on above  
Section Plat

If a producing well is abandoned, date of last production Sept. 19 64  
Was permission obtained from the Conservation Division or its agents before plugging was commenced? Yes

Name of Conservation Agent who supervised plugging of this well Edon Pottey  
Producing formation Marmaton Depth to top 4316 Bottom \_\_\_\_\_ Total Depth of Well 4565' Feet  
Show depth and thickness of all water, oil and gas formations.

OIL, GAS OR WATER RECORDS

CASING RECORD

FORMATION	CONTENT	FROM	TO	SIZE	PUT IN	PULLED OUT
				8 5/8	268	none
				4 1/2	4563	2710

Describe in detail the manner in which the well was plugged, indicating where the mud fluid was placed and the method or methods used in introducing it into the hole. If cement or other plugs were used, state the character of same and depth placed, from \_\_\_\_\_ feet to \_\_\_\_\_ feet for each plug set.

Mix 10 sacks cement to plug off perforations at 3897. Stop plug at 3800'. Circulate well and spot 20 sacks cement at 700'. 20 sacks cement at 240' and 10 sacks cement 35' to 0'.

RECEIVED  
STATE CORPORATION COMMISSION

JUL 13 1965

CONSERVATION DIVISION  
WICHITA, KANSAS

(If additional description is necessary, use BACK of this sheet)  
Name of Plugging Contractor Sargent's Casing Pulling Service  
Address Box 506 Liberal, Kansas

STATE OF Kansas, COUNTY OF Seward, ss.

(employee of owner) or (owner or operator) of the above-described well, being first duly sworn on oath, says: That I have knowledge of the facts, statements, and matters herein contained and the log of the above-described well as filed and that the same are true and correct. So help me God.

(Signature) W. R. Atkinson  
Box Liberal Kansas  
(Address)

SUBSCRIBED AND SWORN TO before me this 12<sup>th</sup> day of July, 1965

My commission expires April 9, 1968  
Karolyn Galster  
Notary Public.

DRILLER'S LOG

COMPANY:  
CONTRACTOR:  
LEASE:  
LOCATION:  
COMMENCED:  
COMPLETED:  
CASING:

CIMARRON EXPLORATION, INC. Company, Inc.  
Hellar Drilling Company, Inc.  
#1 Selsor  
c NE NE 6-18S-26W, Ness County, Kansas  
October 15, 1963  
October 28, 1963  
Set 8 5/8" surface casing @ 273'/215 sacks cement  
Set 4 1/2" casing @ 4441'/200 sacks cement

0-100	Surface Sand
100-273	Sand and shale
273-1366	Shale & sand w/ shell streaks
1366-1383	Blaine-Anhydrite
1383-1720	Red Bed, sand & shale
1720-1958	Red Bed, shale & sand
1958-1977	Cimarron Anhydrite
1977-1995	Anhydrite
1995-2213	Shale & Red Bed & salt section
2213-2620	Salt Section
2620-2780	Lime & shale
2780-2989	Ft. Riley
2989-3911	Lime & shale
3911-4025	Lsg.-K.C.
4025-4072	Lime
4072-4183	Lst.-K.C.
4183-4223	Lime & shale
4223-4330	Marmaton
4330-4417	Lime & shale
4417-4460	Ft. Scottlime
4460-4476	Lime & shale
4476-4510	Lime & chert
4510-4549	Mississippian
4549-4568	Mississippian lime
4568	Rotary Total Depth

RECEIVED  
STATE CORPORATION COMMISSION  
JUL 13 1965  
CONSERVATION DIVISION  
Wichita, Kansas

STATE OF KANSAS )  
                          ) SS  
COUNTY OF SEDGWICK )

I, D. L. Hollar, do hereby certify that the above and foregoing is a true and correct copy of the log of the #1 Selsor, located in c NE NE 6-18S-26W, Ness County, Kansas, as reflected by the files of the Hellar Drilling Company, Inc.

HELLAR DRILLING COMPANY, INC.

By D. L. Hollar  
President - D. L. Hollar

Subscribed and sworn to before me, a Notary Public, in and for Sedgwick County, Kansas, this 26th day of November, 1963.

My Commission Expires: March 25, 1964

Catherine Darcey  
Notary Public - Catherine Darcey