


15-135-30132-0000

WELL PLUGGING RECORD

Give All Information Completely
Make Required Affidavit
Mail or Deliver Report to:
Conservation Division
State Corporation Commission
212 North Market, Insurance Bldg.
Wichita, Kansas

NESS County. Sec. 5 Twp. 18S Rge. (E) 26 (W)

Location as "NE/CNW/SW" or footage from lines C SW NE
Lease Owner W. A. MONCRIEF
Lease Name R. L. SARGENT Well No. 1
Office Address 9TH AT COMMERCE, FORT WORTH, TEXAS
Character of Well (completed as Oil, Gas or Dry Hole) DRY HOLE
Date well completed DEC. 16, 1965
Application for plugging filed (12-16-65 PHONE) DEC. 20, 1965
Application for plugging approved DEC. 16, 1965
Plugging commenced DEC. 16, 1965
Plugging completed DEC. 16, 1965
Reason for abandonment of well or producing formation

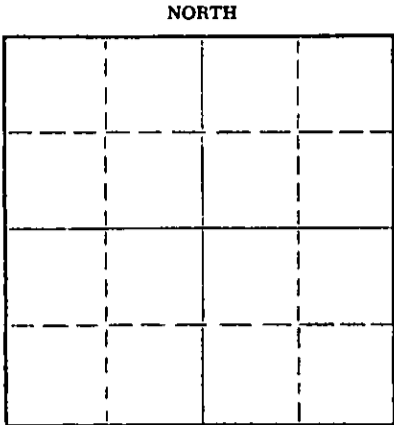

Locate well correctly on above Section Plat

If a producing well is abandoned, date of last production 19
Was permission obtained from the Conservation Division or its agents before plugging was commenced? YES

Name of Conservation Agent who supervised plugging of this well HAROLD HOLLIS AND GILBERT LIEKER
Producing formation _____ Depth to top _____ Bottom _____ Total Depth of Well 4537 Feet
Show depth and thickness of all water, oil and gas formations.

OIL, GAS OR WATER RECORDS

CASING RECORD

FORMATION	CONTENT	FROM	TO	SIZE	PUT IN	PULLED OUT
		0	252	8-5/8	252	NONE

Describe in detail the manner in which the well was plugged, indicating where the mud fluid was placed and the method or methods used in introducing it into the hole. If cement or other plugs were used, state the character of same and depth placed, from _____ feet to _____ feet for each plug set.

FILLED HOLE WITH HEAVY MUD TO 550 FEET. SET FIRST PLUG @ 550 FEET WITH 25 SACKS CEMENT.
FILLED HOLE WITH HEAVY MUD TO 245 FEET. SET SECOND PLUG @ 245 FEET WITH 1/4 SACK HULLS AND 20 SACKS CEMENT. FILLED HOLE WITH HEAVY MUD TO 40 FEET. SET THIRD PLUG @ 40 FEET WITH 1/4 SACK HULLS AND 15 SACKS CEMENT. FILLED RAT HOLE AND CEMENTED WITH 2 SACKS CEMENT.

RECEIVED
STATE CORPORATION COMMISSION
DEC 21 1965
CONSERVATION DIVISION
Wichita, Kansas

(If additional description is necessary, use BACK of this sheet)

Name of Plugging Contractor GABBERT-JONES, INC.
Address 514 ORPHEUM BLDG., WICHITA, KANSAS

STATE OF KANSAS, COUNTY OF SEDGWICK, ss.
E. E. HALL (employee of owner) or (owner or operator) of the above-described well, being first duly sworn on oath, says: That I have knowledge of the facts, statements, and matters herein contained and the log of the above-described well as filed and that the same are true and correct. So help me God.

(Signature) *E. E. Hall*
514 ORPHEUM BLDG., WICHITA, KANSAS
(Address)

SUBSCRIBED AND SWORN TO before me this 20TH day of DECEMBER, 1965

My commission expires FEBRUARY 1, 1968
Barbara J. Layton
BARBARA J. LAYTON Notary Public.



GABBERT-JONES, INC.
WICHITA, KANSAS
DRILLERS' WELL LOG

R. L. SARGENT #1
C SW NE SECTION 5-18S-26W
NESS COUNTY, KANSAS

COMMENCED: DECEMBER 6, 1965
COMPLETED: DECEMBER 16, 1965

OPERATOR - W. A. MONCRIEF

DEPTH		FORMATION	REMARKS
FROM	TO		
0	252	SHELLS AND BLUE SHALE	RAN 252' OF 8-5/8" CASING, SET @ 252' w/180 SACKS CEMENT.
252	1800	SHALE AND SHELLS	
1800	3955	LIME AND SHALE	
3955	4537	LIME	
4537	TO		DRY AND ABANDONED.

I, E. E. HALL, CERTIFY THIS IS A CORRECT COPY OF THE DRILLERS' LOG FOR THE WELL DRILLED IN THE C SW NE SECTION 5-18S-26W, NESS COUNTY, KANSAS, TO THE BEST OF MY KNOWLEDGE AND BELIEF.

E. E. HALL

STATE OF KANSAS)
) SS
COUNTY OF SEDGWICK)

BEFORE ME, THE UNDERSIGNED, A NOTARY PUBLIC WITHIN AND FOR SAID COUNTY AND STATE, ON THIS 20TH DAY OF DECEMBER, 1965, PERSONALLY APPEARED E. E. HALL, TO ME PERSONALLY KNOWN TO BE THE IDENTICAL PERSON WHO EXECUTED THE WITHIN AND FOREGOING INSTRUMENT AND ACKNOWLEDGED TO ME THAT HE EXECUTED THE SAME AS HIS FREE AND VOLUNTARY ACT AND DEED FOR THE USES AND PURPOSES THEREIN SET FORTH.

IN WITNESS WHEREOF, I HAVE HEREUNTO SET MY HAND AND OFFICIAL SEAL THE DAY AND YEAR LAST ABOVE WRITTEN.

BARBARA J. LAYTON, NOTARY PUBLIC

MY COMMISSION EXPIRES FEBRUARY 1, 1968.

RECEIVED
STATE CORPORATION COMMISSION
DEC 21 1965
CONSERVATION DIVISION
Wichita, Kansas