
15-135-00176-0000

STATE OF KANSAS
STATE CORPORATION COMMISSION

Give All Information Completely
Make Required Affidavit
Mail or Deliver Report to:
Conservation Division
State Corporation Commission
212 North Market, Insurance Bldg.
Wichita, Kansas

WELL PLUGGING RECORD

NORTH

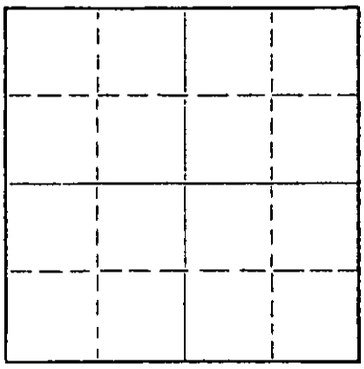

Locate well correctly on above Section Plat

Ness County. Sec. 29 Twp. 18 Rge. 26 (E) (W)

Location as "NE/CNW¼SW¼" or footage from lines NW NW NE

Lease Owner Pickrell Drilling Company

Lease Name Reeves Well No. # 1

Office Address 2820 Paseo Great Bend, Kansas

Character of Well (completed as Oil, Gas or Dry Hole)

Date well completed 19

Application for plugging filed yes 19

Application for plugging approved yes 19

Plugging commenced 5-30-61 19

Plugging completed 6-6-61 19

Reason for abandonment of well or producing formation

If a producing well is abandoned, date of last production 19

Was permission obtained from the Conservation Division or its agents before plugging was commenced? yes

Name of Conservation Agent who supervised plugging of this well G. P. Leiker

Producing formation Depth to top Bottom Total Depth of Well PB 4600' Feet

Show depth and thickness of all water, oil and gas formations.

OIL, GAS OR WATER RECORDS — CASING RECORD

FORMATION	CONTENT	FROM	TO	SIZE	PUT IN	PULLED OUT
				5½"		2,813'

Describe in detail the manner in which the well was plugged, indicating where the mud fluid was placed and the method or methods used in introducing it into the hole. If cement or other plugs were used, state the character of same and depth placed, from feet to feet for each plug set.

Plugging commenced 5-30-61. Plugging completed 6-6-61.

Measured in to total depth: Plug at 4600'.

Plugged off bottom:
Sanded back to 4530' and dumped 5 sacks of cement.

Worked and shot casing. Worked & shot 5½" casing free at 2813'. Built rack and slide. Pulled and layed down casing.

Plugged well: Mudded up to 300' and set 10' rock bridge at 300'. Dumped 20 sacks of cement. Mudded up to 40' and set 10' rock bridge at 40'. Capped the well with 10 sacks of cement.

(If additional description is necessary, use BACK of this sheet)

Name of Plugging Contractor Forbes Casing Pulling, Inc.

Address P. O. Box 221 Great Bend, Kansas

STATE OF Kansas, COUNTY OF Barton, ss.

J. O. Forbes (employee of owner) or (owner or operator) of the above-described well, being first duly sworn on oath, says: That I have knowledge of the facts, statements, and matters herein contained and the log of the above-described well as filed and that the same are true and correct. So help me God.

(Signature) J. O. Forbes

Great Bend, Kansas
(Address)

SUBSCRIBED AND SWORN TO before me this 12th day of June, 1961

Kayann Jenkins
Notary Public.

My commission expires December 8th, 1963

RECEIVED
STATE CORPORATION COMMISSION
JUN 21 1961
CONSERVATION DIVISION
Wichita, Kansas

6-VH

15-135-00176-0000

ROTARY DRILLING LOG

COMPANY: Pickrell Drilling Company
705 Fourth National Bank Bldg.
Wichita 2, Kansas

Rotary Drilling Commenced 3-23-61

Rotary Drilling Completed 4-9-61

LOCATION: NEEVEL NO. 1 - NW/4 NW/4 NE/4
Section 29-18S-26W
Ness County, Kansas

CONTRACTOR: PICKRELL DRILLING COMPANY
Wichita, Kansas

CASING RECORD: Ran 7 jts. 20# 8 5/8" Surface Casing, set at 311' w/ 175 sx cem. Circulated.
Ran 147 jts 14#, 5 1/2" Sule Casing. Set at 4622, cemented w/100 sx cem.

LOG

(Figures indicate bottom of formation — measurements from top of rotary bushing.)

230'	Clay
615'	Blue Shale
675'	Sand & Shale
845'	Grey Shale
1100'	Shale
1120'	Sand
1345'	Red Bed, Shale & Streaks Sand
1370'	Elaine
1440'	Red Bed & Shale
1680'	Sand
1955'	Red Bed & Shale
1995'	Anhydrite
2560'	Shale & Shells
2710'	Lime & Shale
2765'	Sandy lime & Shale
2880'	Lime
3347'	Lime & Shale
3480'	Lime, Sand & Shale
3710'	Lime & Shale
3820'	Lime, Shale & Sand
3897'	Lime
4000'	Lime & Shale
4030'	Lime
4105'	Lime & Shale
4475'	Lime
4545'	Lime & Shale
4556'	Sand
4566'	Sand & Shale
4583'	Chert
4565'	Chert
4583'	Miss. Dolomite
4593'	Miss. Dolomite
4625'	Mississippian T.D.

Circulate for Samples

4447'
4487'
4548'
4551'
4556'
4561'
4566'
4575'
4585'
4593'

Slope Test

1400'
2310'
2870'
3347
3820'
4330'

S. L. M.

3480'
3897'
4515'

RECEIVED
STATE CORPORATION COMMISSION
JUN 21 1961
CONSERVATION DIVISION
Wichita, Kansas

The undersigned, C. W. Sebits, Attorney-in-Fact for PICKRELL DRILLING COMPANY, hereby certifies in behalf of said Company, that the above is a true and correct log of the formation encountered in drilling the above well as reflected by the Daily Drilling Reports.

PICKRELL DRILLING COMPANY

By _____ Attorney-in-Fact

C.W. Sebits

STATE OF KANSAS
COUNTY OF SEDGWICK } ss.:

On this 20th day of April, 19 61, before me the undersigned, a Notary Public, in and for the County and State aforesaid, personally appeared C. W. Sebits, to me known to be the identical person who subscribed the name of PICKRELL DRILLING COMPANY to the foregoing instrument as its Attorney-in-Fact and acknowledged to me that he executed the same as his free and voluntary act and deed, and as the free and voluntary act and deed of such company, for the uses and purposes therein set forth.

Given under my hand and seal of office the day and year last above written.

Maxine Johnson
Notary Public

My commission expires: September 24, 1962

Maxine Johnson