


WELL PLUGGING RECORD

Give All Information Completely
Make Required Affidavit
Mail or Deliver Report to:
Conservation Division
State Corporation Commission
211 No. Broadway
Wichita, Kansas

Ness County, Sec. 5 Twp. 20S Rge. 21 (X) W (W)
Location as "NE/CNWxSWx" or footage from lines C NE SW
Lease Owner Socony Mobil Oil Company, Inc.
Lease Name Herbert Moore "A" Well No. 1
Office Address 300 No. Broadway - Wichita, Kansas - 67202
Character of Well (completed as Oil, Gas or Dry Hole) Drilled Dry
Date well completed Drilled & abandoned 19
Application for plugging filed 5-19-64 19
Application for plugging approved 5-13-64 (Verbal) 19
Plugging commenced 5-13-64 19
Plugging completed 5-13-64 19
Reason for abandonment of well or producing formation Drilled Dry

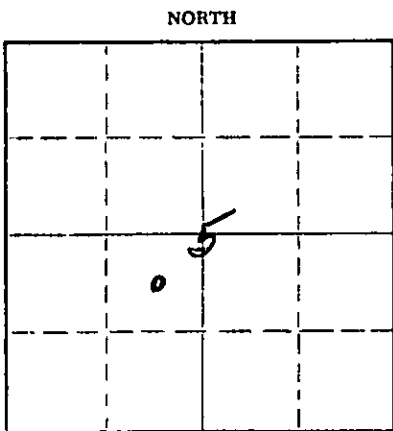

Locate well correctly on above
Section Plat

If a producing well is abandoned, date of last production - 19
Was permission obtained from the Conservation Division or its agents before plugging was commenced? Yes

Name of Conservation Agent who supervised plugging of this well Archie Elving
Producing formation - Depth to top - Bottom - Total Depth of Well - Feet
Show depth and thickness of all water, oil and gas formations.

OIL, GAS OR WATER RECORDS

CASING RECORD

FORMATION	CONTENT	FROM	TO	SIZE	PUT IN	PULLED OUT
				8 5/8"	319'	0

Describe in detail the manner in which the well was plugged, indicating where the mud fluid was placed and the method or methods used in introducing it into the hole. If cement or other plugs were used, state the character of same and depth placed, from feet to feet for each plug set.

Spotted 20 sacks cement at 660' and filled with mud and hulls to 310'. Spotted 20 sacks cement at 310'. Filled with mud and 1/2 sacks hulls to 40' with wiper plug @ 35'. Filled base of cellar with 10 sacks cement. Plug rat hole with mud and hulls.

RECEIVED
STATE CORPORATION COMMISSION

MAY 22 1964

CONSERVATION DIVISION
Wichita, Kansas

(If additional description is necessary, use BACK of this sheet)
Name of Plugging Contractor Red Tiger Drilling Company
Address 1720 Wichita Plaza, Wichita, Kansas 67202

STATE OF Kansas COUNTY OF Sedgwick ss.
T. L. Gage (employee of owner) of the above-described well, being first duly sworn on oath, says: That I have knowledge of the facts, statements, and matters herein contained and the log of the above-described well as filed and that the same are true and correct. So help me God.

(Signature) T. L. Gage Dist. Group Supvr.
300 No. Broadway - Wichita, Kansas - 67202
(Address)

SUBSCRIBED AND SWORN TO before me this 19 day of May, 1964

Jack Bearden
Notary Public.

My commission expires 4-4-66

DRILLERS LOG

No. 1 H. Moore "A"

CASING RECORD: 3 5/8" O 310' w/275 BK cement
 COMPANY: Mobil Oil Company
 CONTRACTOR: Red Tiger Drilling Co.
 COMMENCED: April 30, 1964
 COMPLETED: May 13, 1964
 DESCRIPTION: C NE SW 5-203-21W No. 1 Co., Kansas
 ELEVATION: 2250 DF 2230 RB

TOTAL DEPTH: 4665'

<u>FORMATION</u>	<u>FROM</u>	<u>TO</u>	<u>REMARKS</u>
Surface Soil, Clay & Rock	0	321	
Shale & Clay	321	355	
Sand	355	383	
Shale	383	1005	
Sand	1005	1107	
Shale & Red Bed	1107	1430	
Anhydrite	1430	1514	
Shale & Shells	1514	1635	
Shale, Shells & Salt	1635	1937	
Shale & Lime	1937	3775	
Lime	3775	4105	
Lime, Shale & Cherts	4105	4243	
Shale & Lime	4243	4424	
Mississippi Cherts	4424	4665	

RECEIVED
 STATE CORPORATION COMMISSION
 MAY 22 1964
 CONSERVATION DIVISION
 Wichita, Kansas

I certify that this is a true and correct copy of the above log to the best of my knowledge.

RED TIGER DRILLING COMPANY

Mervin V. Head
 Mervin V. Head

Subscribed and sworn to before me this 15th day of May, 1964.

Jerry Hollas
 Notary Public

My Commission Expires:
5-22-66