


WELL PLUGGING RECORD

Give All Information Completely
Make Required Affidavit
Mail or Deliver Report to:
Conservation Division
State Corporation Commission
800 Bittling Building
Wichita, Kansas

Less _____ County. Sec. 28 Twp. 18 Rge. 24 (~~25~~) (W)
Location as "NE/CNW/SW" or footage from lines NE 1/4 23
Lease Owner Welch & Olsson Drilling Co. Inc.
Lease Name Cranston Well No. 1
Office Address 203 Rule Bldg. Wichita, Kansas
Character of Well (completed as Oil, Gas or Dry Hole) D & A
Date well completed 7-23 19 55
Application for plugging filed 7-23 19 55
Application for plugging approved 7-23 19 55
Plugging commenced 7-24 19 55
Plugging completed 7-24 19 55
Reason for abandonment of well or producing formation D. & A.

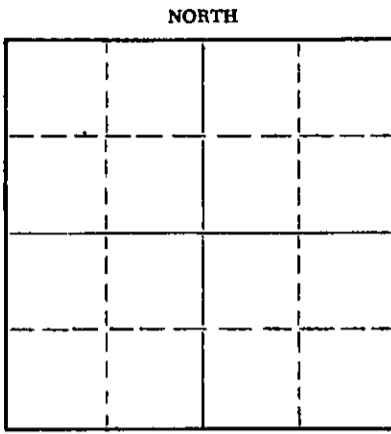

Locate well correctly on above Section Plat

If a producing well is abandoned, date of last production none 19 _____
Was permission obtained from the Conservation Division or its agents before plugging was commenced? Yes

Name of Conservation Agent who supervised plugging of this well Warren H. Horner, Box 207, Great Bend, Kansas.
Producing formation _____ Depth to top _____ Bottom _____ Total Depth of Well 4370 Feet
Show depth and thickness of all water, oil and gas formations.

OIL, GAS OR WATER RECORDS

CASING RECORD

FORMATION	CONTENT	FROM	TO	SIZE	PUT IN	PULLED OUT
				8 5/8"	208	None

Describe in detail the manner in which the well was plugged, indicating where the mud fluid was placed and the method or methods used in introducing it into the hole. If cement or other plugs were used, state the character of same and depth placed, from _____ feet to _____ feet for each plug set.

Mudded to 200'. Set wooden plug. Cemented and displaced with 100 sacks of cement, with cement pump truck.

RECEIVED
STATE CORPORATION COMMISSION
AUG 19 1955
CONSERVATION DIVISION

(If additional description is necessary, use BACK of this sheet)
Name of Plugging Contractor Welch & Olsson Drilling Company, Inc.
Address 203 Rule Bldg. Wichita, Kansas.

STATE OF Kansas, COUNTY OF Sedgewick, ss.
R. L. Welch (employee of owner or (owner or operator) of the above-described well, being first duly sworn on oath, says: That I have knowledge of the facts, statements, and matters herein contained and the log of the above-described well as filed and that the same are true and correct. So help me God.

(Signature) [Signature]
203 Rule Bldg. Wichita, Ks. (Address)

SUBSCRIBED AND SWORN TO before me this 28th day of July, 19 55

June 12, 1959
My commission expires _____
[Signature] Notary Public.

PLUGGING
FILE SEC 28 T 18 R 24 W
BOOK PAGE 38 LINE 3

WELL LOG.

WELCH & OLSSON DRILLING COMPANY, INC.	ELEVATION:	2294 L.S.
CONTRACTOR: Welch & Olsson Drilling Co. Inc.	Comm. Drlg:	7-9-55
CAMSTON #1	Compl. Drlg:	7-23-55
NE NW NE Sec. 23-18-24W	Production:	D & A
Wass County, Kansas.		

Casing Record:
 Set 208' of 8 5/8" with 175 sacks of cement

(Figures indicated bottom of formations.)

<u>FORMATIONS</u>	<u>DEPTHS</u>	<u>FORMATION TOPS</u>
Clay & Sand	70	Leebner: 3671 (-1377)
Shale & Shells:	208	Lansing-Kansas: 3711 (-1417)
Shale:	475	Base Kansas City: 4004 (-1710)
Sand:	580	Mt. Scott Lime: 4224 (-1930)
Shale:	720	Cherokee Section: 4290 (-1996)
Sand:	790	Mississippi: 4318 (-2024)
Shale & Red Bed:	930	
Anhydrite:	1350	
Shale & Shells:	2200	
Lime & Shale:	2315	
Lime:	2305	
Shale & Lime:	3070	
Shale & Shells:	3320	
Shale & Shells W/Lime	3365	
Shale & Lime:	3515	
Lime & Shale:	3577	
Lime:	3655	
Lime & Shale:	3715	
Lime:	4070	
Lime & Shale:	4160	
Lime:	4220	
Shale & Lime:	4285	
Lime & Shale:	4296	
Sand:	4315	
Sand & Shale:	4330	
Lime:	4370 T.D.	

RECORDED
 COMMISSION
 AUG 24 1955

STATE OF KANSAS,)
) SS:
 WASHINGTON COUNTY,)

I hereby certify that the above is a true and correct copy of Drillers Log of well drilled in the NW NW NE of Section 28, Township 18, Range 24 West, Wass County, Kansas.

WELCH & OLSSON DRILLING COMPANY, INC.

BY [Signature]
 R. L. WELCH

Subscribed and sworn to before me this 1st day of August, 1955.

[Signature]
 Notary Public.

My commission expires:
 June 12, 1959.

PLUGGING
 FILE NO. 28-18-R-240
 BOOK PAGE 138 LINE 3