


WELL PLUGGING RECORD

Give All Information Completely
Make Required Affidavit
Mail or Deliver Report to:
Conservation Division
State Corporation Commission
212 North Market, Insurance Bldg.
Wichita, Kansas

Ness County. Sec. 28 Twp. 18S Rge. 24 (K) (W)
Location as "NE/CNW/SE/SW" or footage from lines NW/4 NW/4 NE/4
Lease Owner D. E. Dunne, Jr.
Lease Name Cranston Well No. 1A
Office Address 1005 Central Building, Wichita, Kansas
Character of Well (completed as Oil, Gas or Dry Hole) Dry
Date well completed 12-3 19 60
Application for plugging filed 12-3 19 60
Application for plugging approved 12-3 19 60
Plugging commenced 12-3 19 60
Plugging completed 12-3 19 60
Reason for abandonment of well or producing formation
Unable to reopen and wash down old hole
If a producing well is abandoned, date of last production 19
Was permission obtained from the Conservation Division or its agents before plugging was commenced? Yes

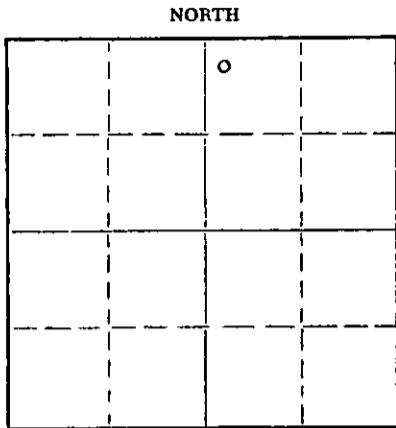

Locate well correctly on above Section Plat

Name of Conservation Agent who supervised plugging of this well Eldon Petty, Hays, Kansas
Producing formation _____ Depth to top _____ Bottom _____ Total Depth of Well 4320 Feet
Show depth and thickness of all water, oil and gas formations.

OIL, GAS OR WATER RECORDS

CASING RECORD

FORMATION	CONTENT	FROM	TO	SIZE	PUT IN	PULLED OUT
				8 5/8"	208	-

Describe in detail the manner in which the well was plugged, indicating where the mud fluid was placed and the method or methods used in introducing it into the hole. If cement or other plugs were used, state the character of same and depth placed, from _____ feet to _____ feet for each plug set.

Set plug with hulls @ 200'
Cement through drill pipe with 20 sacks cement
Filled hole up to 35' of base of cellar with rotary mud
Set plug and hulls. Cap with 10 sacks cement
Plug rat hole with 2 sacks cement
12-13-60
COUNCIL
Wichita, Kansas

(If additional description is necessary, use BACK of this sheet)
Name of Plugging Contractor Twin Drilling, Inc.
Address 1005 Central Building, Wichita, Kansas

STATE OF Kansas, COUNTY OF Sedgwick, ss.
Almeda Day (employee of owner) or (owner or operator) of the above-described well, being first duly sworn on oath, says: That I have knowledge of the facts, statements, and matters herein contained and the log of the above-described well as filed and that the same are true and correct. So help me God

(Signature) Almeda Day
1005 Central Building, Wichita, Kansas
(Address)

SUBSCRIBED AND SWORN TO before me this 12 day of December, 19 60

My commission expires September 29, 1964
James S. Hicks
Notary Public.

